

Harrison  
L 222  
9-5-69

MISSISSIPPI  
 BOARD OF WATER COMMISSIONERS  
 416 North State Street  
 Jackson, Mississippi 39201

CODE 1

WATER WELL DRILLERS LOG

9-5 1969 R. J. Moore HARRISON  
 date well completed firm name county well located


LANDOWNER: <u>HAROLD E. LEROY</u> <u>CROTHARDS RD</u>	description of formations encountered	from	to
<u>GULFPORT</u> (mailing address)	<u>SURFACE SOIL</u>	<u>0</u>	<u>13</u>
	<u>WHITE SAND</u>	<u>10</u>	<u>22</u>
	<u>Blue CLAY</u>	<u>22</u>	<u>219</u>
	<u>GRAY SAND</u>	<u>219</u>	<u>240</u>
WELL LOCATION: sec <u>3</u> T <u>2</u> N <u>5</u> R <u>11</u> E <u>W</u> <u>2</u> miles <u>EAST</u> of <u>MISSANT</u> (distance) (direction) (nearest town)			
WELL PURPOSE: (home, irrigation, municipal, industrial)			
WELL COMPLETION DATA:			
(1) diameter (inches) <u>2"</u>			
(2) total depth (feet) <u>240'</u>			
(3) static water level (feet) <u>42</u> <u>below</u> above top of ground.			
(4) casing <u>4 1/2"</u> <u>230'</u> (material) (depth)			
<u>2"</u> If telescope see back. (size)			
(5) screen <u>2x10</u> <u>230'</u> (length) (depth to top)			
<u>2"</u> <u>SS</u> (size) (material)			
(6) pump _____ (HP) (yield gpm)			
(type power)			
(7) electric log _____ (yes or no)			
(organization running log)			
(8) how well bottom plugged _____			
DRILLERS REMARKS:			

SEP 29 1969

MISS. BD. OF  
 WATER CONTROL

If well telescopes please sketch and show depths.

GROUND LEVEL

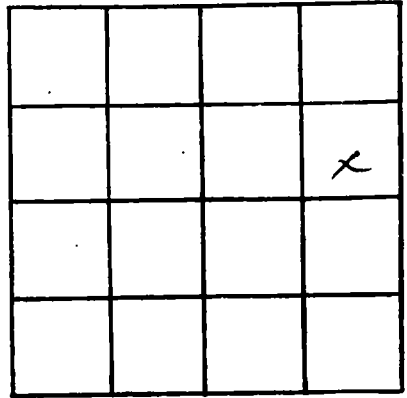

SECTION 3

Please indicate well location X.

ADDITIONAL INFORMATION

If more than one screen, show locations of each on sketch.