

Harrison
 L 226
 8-8-69

MISSISSIPPI
 BOARD OF WATER COMMISSIONERS
 416 North State Street
 Jackson, Mississippi 39201

CODED
 CODED

WATER WELL DRILLERS LOG

8-8 1969 Lutter Well Wks. Harrison
 date well completed firm name county well located

LANDOWNER: DR. A.V. HAYS

1500 EAST BEACH

Miss. City, Miss.
 (mailing address)

WELL LOCATION:

sec. 28 T 7 N R 11 E W

_____ miles IN Gulfport
 (distance) (direction) (nearest town)

WELL PURPOSE: home
 (home, irrigation, municipal, industrial)

WELL COMPLETION DATA:

- (1) diameter (inches) 2x4"
- (2) total depth (feet) 483'
- (3) static water level (feet) 6' below
 top of ground.
- (4) casing galv. 473'
 (material) (depth)
 2 1/4" if telescope see back.
 (size)
- (5) screen 10' 473'
 (length) (depth to top)
 2" stainless steel
 (size) (material)
- (6) pump 1 1/2 30
 (HP) (yield gpm)
 elec
 (type power)
- (7) electric log no
 (yes or no)

(organization running log)

(8) how well bottom plugged B.P. Value

description of formations encountered

from to

Rand	0	15
clay	15	42
sand	42	57
clay	57	433
sand	433	483

DRILLERS REMARKS:

MISS. BD. OF
 WATER COMM.

JAN 12 1970


If well telescopes please sketch and show depths.

GROUND LEVEL

105' of 4" galv.

368' of 2" galv.

2 x 10 S.S. Struc.

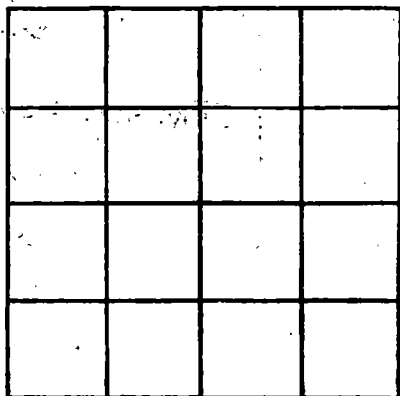

SECTION _____

Please indicate well location X.

ADDITIONAL INFORMATION

If more than one screen, show locations of each on sketch.