

Harrison  
L 229  
10-22-69

MISSISSIPPI  
 BOARD OF WATER COMMISSIONERS  
 416 North State Street  
 Jackson, Mississippi 39201

CODED  
 CODED

WATER WELL DRILLERS LOG

10-22 1969 Sutter Well Wks. Harrison  
 date well completed firm name county well located

LANDOWNER: Alpine Corp  
Guelfort  
 (mailing address)

description of formations encountered	from	to
<u>Clay</u>	<u>0</u>	<u>18</u>
<u>sand</u>	<u>18</u>	<u>32</u>
<u>Clay</u>	<u>32</u>	<u>647</u>
<u>sand</u>	<u>647</u>	<u>677</u>

WELL LOCATION:  
 sec. 22 T 7 S R 11 W  
 (distance) miles IN (direction) of Guelfort (nearest town)

WELL PURPOSE: Industrial  
 (home, irrigation, municipal, industrial)

- WELL COMPLETION DATA:
- (1) diameter (inches) 4"
  - (2) total depth (feet) 677'
  - (3) static water level (feet) 8' below above top of ground.
  - (4) casing Blk steel 657'  
 (material) (depth)  
4"  
 (size) If telescope see back.
  - (5) screen 20' 657'  
 (length) (depth to top)  
4" Stainless steel  
 (size) (material)
  - (6) pump unknown  
 (HP) (yield gpm)  
 (type power)
  - (7) electric log no  
 (yes or no)  
 (organization running log)
  - (8) how well bottom plugged B.P. Valve


DRILLERS REMARKS:

JAN 12 1970

MISS. BD. OF  
 WATER COMM.

If well telescopes please sketch and show depths.

GROUND LEVEL

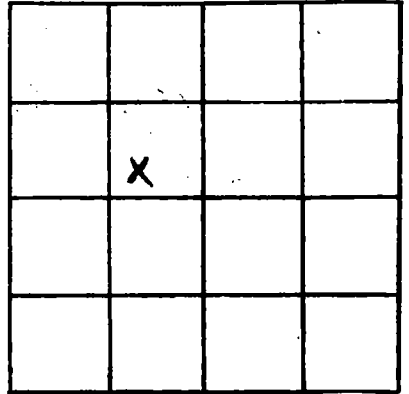

SECTION 22

Please indicate well location X.

ADDITIONAL INFORMATION

If more than one screen, show locations of each on sketch.