

Harrison
L 230
12-11-69

MISSISSIPPI
 BOARD OF WATER COMMISSIONERS
 416 North State Street
 Jackson, Mississippi 39201

CODED

CODED

WATER WELL DRILLERS LOG

12-11 1969 B J Moske HARRISON
 date well completed firm name county well located

LANDOWNER: Robt. H. Foster

description of formations encountered

from to

Robinson Road Rt #1

<u>TOP SOIL</u>	<u>0</u>	<u>18</u>
<u>Red SAND</u>	<u>18</u>	<u>30</u>
<u>Red to white Clay</u>	<u>30</u>	<u>90</u>
<u>Blue Clay</u>	<u>90</u>	<u>170</u>
<u>White Sand</u>	<u>170</u>	<u>200</u>

Gulfport MISS.
 (mailing address)

WELL LOCATION:

sec. 6 T 2 N R. 11 E
 (distance) (direction) (nearest town)

2 miles WEST of NOBLET

WELL PURPOSE:
 home irrigation, municipal, industrial

WELL COMPLETION DATA:

- (1) diameter (inches) 2"
- (2) total depth (feet) 200'
- (3) static water level (feet) 40' below top of ground above
- (4) casing 9ALW 190
 (material) (depth)
 (size) If telescope see back.
- (5) screen 2x10 190'
 (length) (depth to top)
2" SS
 (size) (material)
- (6) pump — —
 (HP) (yield gpm)
 (type power)
- (7) electric log —
 (yes or no)
 (organization running log)
- (8) how well bottom plugged B.W
2 1/2 in


DRILLERS REMARKS:

JAN - 9 1970

MISS. BD. OF
 WATER COMM.

If well telescopes please sketch and show depths.

GROUND LEVEL

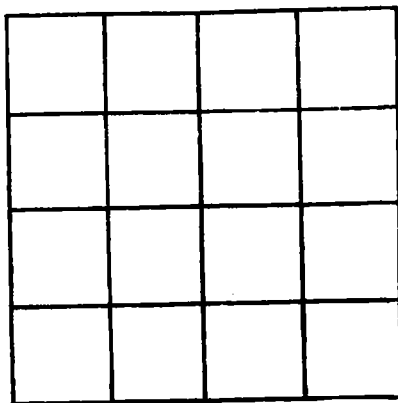

SECTION 6

Please indicate well location X.

ADDITIONAL INFORMATION

If more than one screen, show locations of each on sketch.