

Harrison Co  
 L 234  
 10-69

MISSISSIPPI  
 BOARD OF WATER COMMISSIONERS  
 416 North State Street  
 Jackson, Mississippi 39201

**CODED**

WATER WELL DRILLERS LOG

October 10 1969 Ladin's Well Works Harrison  
 date well completed firm name county well located

LANDOWNER: Bessie A. Sautier  
Landon Rd. Hulfport  
 (mailing address)

description of formations encountered	from	to
yellow clay	40	ft.
white sand	20	ft.
Blue Clay	150	ft.
Fine Blue Sand	40	ft.
Blue Clay	180	ft.
Coarse Blue Sand	30	ft.

WELL LOCATION:  
 sec. 2 T. 7 N. R. 11 E.  
3 miles West of Landon  
 (distance) (direction) (nearest town)

WELL PURPOSE: Home  
 (home, irrigation, municipal, industrial)

- WELL COMPLETION DATA:
- (1) diameter (inches) 2 inch
  - (2) total depth (feet) 460
  - (3) static water level (feet) 30 below top of ground.
  - (4) casing gal., 450,  
 (material) (depth)  
2 inch if telescope see back.  
 (size)
  - (5) screen 10 ft., 450  
 (length) (depth to top)  
2 inch Stainless Steel  
 (size) (material)
  - (6) pump 1/2 H.P. 8  
 (HP) (yield gpm)  
Electric  
 (type power)
  - (7) electric log No  
 (yes or no)

(organization running log)

(8) how well bottom plugged  
Ball Check


DRILLERS REMARKS:

FEB 4 - 1970

MISS. BD. OF  
 WATER COMMISSIONERS

If well telescopes please sketch and show depths.

GROUND LEVEL

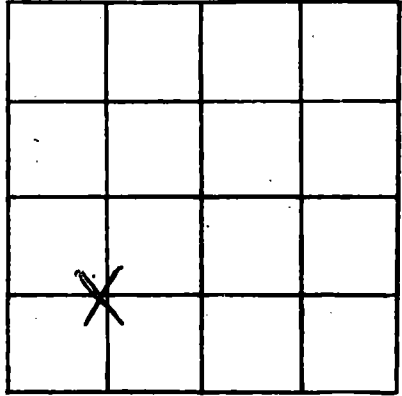

SECTION 2

Please indicate well location X.

ADDITIONAL INFORMATION

Lined area for additional information.

If more than one screen, show locations of each on sketch.