

Harrison Co  
 L 235  
 12-69

MISSISSIPPI  
 BOARD OF WATER COMMISSIONERS  
 416 North State Street  
 Jackson, Mississippi 39201

**CODED**

WATER WELL DRILLERS LOG

December 17 1969 Ladner's Well Works Harrison  
 date well completed firm name county well located

LANDOWNER: Ligano  
Landon Rd.  
Hulport Miss  
 (mailing address)  
 WELL LOCATION:  
 sec. 2 T. 7 N. R. 11 E.  
 S W  
2 1/2 miles West of Landon  
 (distance) (direction) (nearest town)

description of formations encountered	from	to
<u>Yellow Clay &amp; Sand</u>	<u>30</u>	<u>ft</u>
<u>Blue Clay</u>	<u>100</u>	<u>ft</u>
<u>Fine Blue Sand</u>	<u>20</u>	<u>ft</u>
<u>Coarse Blue Sand</u>	<u>45</u>	<u>ft</u>

WELL PURPOSE: Home  
 (home, irrigation, municipal, industrial)


- WELL COMPLETION DATA:
- diameter (inches) 2 inches
  - total depth (feet) 195 ft.
  - static water level (feet) 20 below above top of ground.
  - casing gal. 185  
 (material) (depth)  
2 inch If telescope see back.  
 (size)
  - screen 10 ft. 185  
 (length) (depth to top)  
2 inch Stainless steel  
 (size) (material)
  - pump 1 12  
 (HP) (yield gpm)  
Electric  
 (type power)
  - electric log No  
 (yes or no)  
 (organization running log)
  - how well bottom plugged Ball Check

DRILLERS REMARKS:

FEB 4 - 1970

If well telescopes please sketch and show depths.

GROUND LEVEL

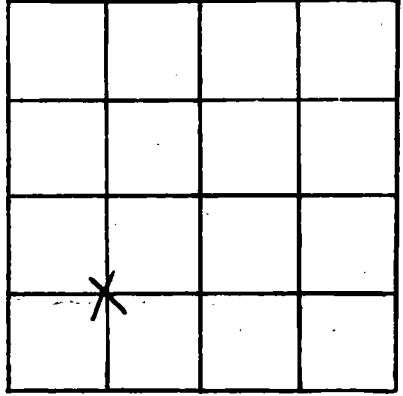

SECTION 2

Please indicate well location X.

ADDITIONAL INFORMATION

If more than one screen, show locations of each on sketch.