

Harrison
L 238
2-11-70

MISSISSIPPI
BOARD OF WATER COMMISSIONERS
416 North State Street
Jackson, Mississippi 39201

CODED

WATER WELL DRILLERS LOG

Feb. 11 1970 M & B Drilling Co. ~~Inc~~ Harrison
date well completed firm name county well located

LANDOWNER: Huie Davis
2919 Adams Street
Culbertson, Miss.
(mailing address)

WELL LOCATION:
sec. 28 T. 7 S. R. 11 W. 6 EPT
1 miles N of Culbertson
(distance) (direction) (nearest town)

WELL PURPOSE: Home
(home, irrigation, municipal, industrial)

WELL COMPLETION DATA:

(1) diameter (inches) 4" X 2"
(2) total depth (feet) 280
(3) static water level (feet) 15 below above top of ground.
(4) casing 110ft 4" PVC 130' 2" Galv. Pipe
(material) (depth)
4 X 2 if telescope see back.
(size)
(5) screen 10 270
(length) (depth to top)
2" Stainless Steel, 010
(size) (material)
(6) pump 1/2 12
(HP) (yield gpm)
220 V 1/2 Submersible
(type power)
(7) electric log No
(yes or no)
(organization running log)
(8) how well bottom plugged 2"
Back Wash Check

description of formations encountered	from	to
Sand	0	37
Grey Clay	37	60
Sand & Shale	60	80
Blue Clay	80	95
Grey Sand	95	125
Dark Grey Clay	125	165
Blue Clay	165	230
Sand	230	280
		Plus

CODED

MAR 12 1970

MISS. BD. OF
WATER

DRILLERS REMARKS:

If well telescopes please sketch and show depths.

GROUND LEVEL

105 →
110 FT →

4" PVC


4" x 2" Aluminum
Packer

2" Colvin
Pipe

270 →

280 →

2" x 10 FT
3010
Stainless
Steel
Strainer

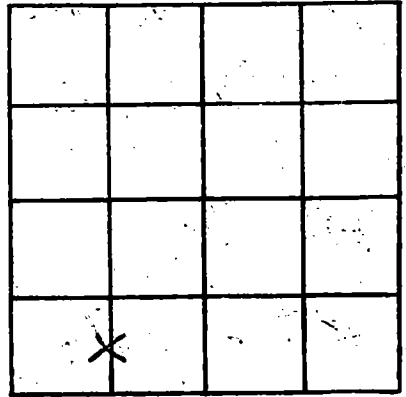

SECTION 28

Please indicate well location X.

ADDITIONAL INFORMATION

If more than one screen, show locations of each on sketch.