

Harrison
L 240
3-27-70

MISSISSIPPI
BOARD OF WATER COMMISSIONERS
416 North State Street
Jackson, Mississippi 39201

WATER WELL DRILLERS LOG

5/27/70 19 Coastal Drilling Co. 11
date well completed firm name well located

COPIED

LANDOWNER: J. F. McPester
At 1 Box 91
J. F. McPester
(mailing address)

WELL LOCATION:
sec. 11 T. 2 N. R. 11 E.
1 1/2 miles W of Lumberton
(distance) (direction) (nearest town)

WELL PURPOSE:
(home, irrigation, municipal, industrial)

WELL COMPLETION DATA:
(1) diameter (Inches) 2"
(2) total depth (feet) 287
(3) static water level (feet) 13 below above top of ground.
(4) casing glau. 277
(material) (depth)
(size) if telescope see back.
(5) screen 10' 277
(length) (depth to top)
2" SS
(size) (material)
(6) pump 1 1/2 18
(HP) (yield gpm)
Electric
(type power)
(7) electric log no
(yes or no)
no
(organization running log)

(8) how well bottom plugged
2 inch mesh wire screen

DRILLERS REMARKS:
none

description of formations encountered	from	to
<u>top soil</u>	<u>1</u>	<u>5</u>
<u>white sand</u>	<u>5</u>	<u>23</u>
<u>Red clay</u>	<u>23</u>	<u>40</u>
<u>white sand</u>	<u>40</u>	<u>57</u>
<u>glau.</u>	<u>57</u>	<u>63</u>
<u>Blue clay</u>	<u>63</u>	<u>233</u>
<u>Shell</u>	<u>233</u>	<u>240</u>
<u>fine water sand</u>	<u>240</u>	<u>260</u>
<u>Coarse water sand</u>	<u>260</u>	<u>287</u>


COPIED

APR - 1 1970

MISS. BD. OF
WATER COMM.

If well telescopes please sketch and show depths.

GROUND LEVEL

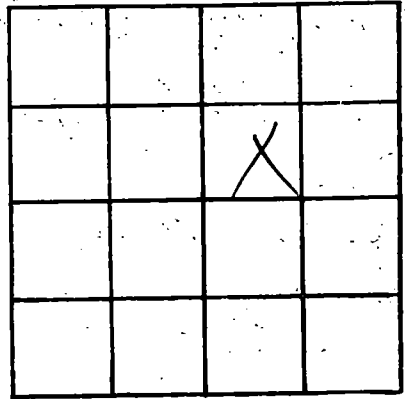

SECTION 11

Please indicate well location X.

ADDITIONAL INFORMATION

If more than one screen, show locations of each on sketch.