

Harrison
L245
5-26-70

MISSISSIPPI
BOARD OF WATER COMMISSIONERS
416 North State Street
Jackson, Mississippi 39201



WATER WELL DRILLERS LOG

5-26 1970 M&B Drilling Co Harrison
date well completed firm name county well located

LANDOWNER: W. A. Lear
Landon Rd
Osifport, Miss.
(mailing address)

description of formations encountered	from	to
Surface	0	6
White Clay	6	15
Black Muck	15	30
Sand Gravel	30	54
Sand & Clay Breaks	54	95
White Clay	95	105
Light Blue Clay	105	135
Like Hard Sand	135	153
Dark Blue Clay	153	165
Fine Sand	165	189
Blue Clay	189	205
Sand	205	230

WELL LOCATION:
sec. 16 T. 7 R. 11
1/2 miles W of Landon
(distance) (direction) (nearest town)

WELL PURPOSE: Home
(home, irrigation, municipal, industrial)

- WELL COMPLETION DATA:
- (1) diameter (inches) 2"
 - (2) total depth (feet) 230
 - (3) static water level (feet) 12 below above top of ground.
 - (4) casing Galv. Steel 22-5
(material) (depth)
2" if telescope see back.
(size)
 - (5) screen 5 FT, 22-5
(length) (depth to top)
2" Stainless Steel, 008
(size) (material)
 - (6) pump 1/2 8
(HP) (yield gpm)
110 Volt
(type power)
 - (7) electric log Yes
(yes or no)
W. S. O. S.
(organization running log)
 - (8) how well bottom plugged
2" Backwash Valve


JUL 9 1970

MISS. BD. OF
WATER COMM.

DRILLERS REMARKS:

If well telescopes please sketch and show depths.

GROUND LEVEL

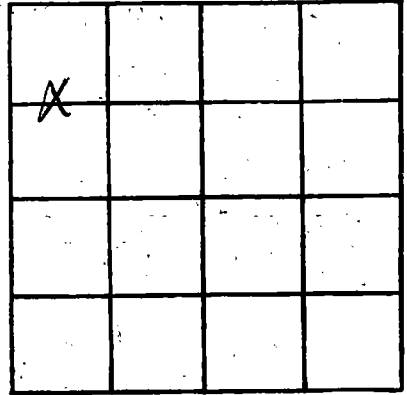

SECTION 16

Please indicate well location X.

ADDITIONAL INFORMATION

If more than one screen, show locations of each on sketch.