

Harrison
 L 250
 -5-6-70

MISSISSIPPI
 BOARD OF WATER COMMISSIONERS
 416 North State Street
 Jackson, Mississippi 39201

CODED

WATER WELL DRILLERS LOG

5-6 1970 P. J. MOORE HARRISON
 date well completed firm name county well located

LANDOWNER: MILTON CASTIGLIA
 ROBINSON ROAD
 GULFPORT MISS -
 (mailing address)

description of formations encountered	from	to
TOP SOIL	0	10
Red TOP Sand	17	25
White Clay	25	75
FINE Sand	75	80
Blue clay	80	104
FINE Sand	104	119
Blue clay	119	224
Blue Sand	224	251

WELL LOCATION:
 sec. 6 T 7 N R 11 E 188
 (distance) miles (direction) of (nearest town)

WELL PURPOSE:
 (home, irrigation, municipal, industrial)

WELL COMPLETION DATA:

(1) diameter (inches) 2"

(2) total depth (feet) 251'

(3) static water level (feet) 75' below above top of ground

(4) casing PVC 240' (material) (depth)

(size) if telescope see back.

(5) screen 2x10 240' (length) (depth to top)

2" 95 (size) (material)

(6) pump (HP) (yield gpm)

(type power)

(7) electric log (yes or no)

(organization running log)

(8) how well bottom plugged BW


DRILLERS REMARKS:

MAY 14 1970

MISS. BD. OF WATER COMM.

If well telescopes please sketch and show depths.

GROUND LEVEL

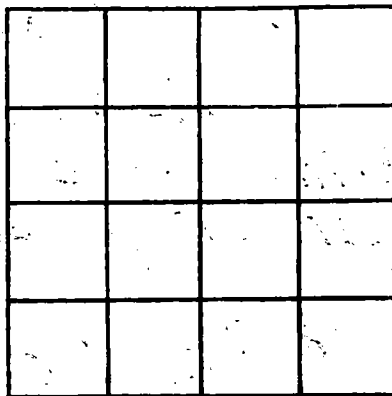

SECTION _____

Please indicate well location X.

ADDITIONAL INFORMATION

If more than one screen, show locations of each on sketch.