

Harrison
L 251
5-30-70

MISSISSIPPI
 BOARD OF WATER COMMISSIONERS
 416 North State Street
 Jackson, Mississippi 39201

CODED

WATER WELL DRILLERS LOG

5-30 1970 R. J. Moore HARRISON
 date well completed firm name county well located


LANDOWNER: <u>Eddie Newman</u>	description of formations encountered		from	to
<u>Rt 1 Box 92</u>	<u>TOP SOIL</u>		<u>0</u>	<u>10</u>
<u>Gulfport Miss</u> (mailing address)	<u>White fine sand</u>		<u>10</u>	<u>30</u>
	<u>Blue + white clay</u>		<u>30</u>	<u>30</u>
WELL LOCATION: <u>188</u>	<u>Blue clay</u>		<u>30</u>	<u>240</u>
sec. <u>11</u> T. <u>7</u> N. R. <u>11</u> E	<u>Blue sand fine</u>		<u>240</u>	<u>260</u>
<u>3</u> miles <u>EAST</u> of <u>DEANSPORTE</u>	<u>Blue clay</u>		<u>260</u>	<u>340</u>
(distance) (direction) (nearest town)	<u>FINE SILTY SAND</u>		<u>340</u>	<u>320</u>
WELL PURPOSE: (home, irrigation, municipal, industrial)	<u>Blue clay</u>		<u>320</u>	<u>555</u>
WELL COMPLETION DATA: <u>188</u>	<u>Grey sand mud</u>		<u>555</u>	<u>580</u>
(1) diameter (inches) <u>2"</u>				
(2) total depth (feet) <u>580</u>				
(3) static water level (feet) <u>18'</u> <u>(below)</u> above top of ground				
(4) casing <u>5440</u> <u>565'</u> (material) (depth)				
<u> </u> If telescope see back. (size)				
(5) screen <u>2x10</u> <u>556</u> (length) (depth to top)				
<u>2"</u> <u>SS</u> (size) (material)				
(6) pump <u>1</u> <u>620 HR</u> (HP) (yield gpm)				
<u>2</u> (type power)				
(7) electric log _____ (yes or no)				
_____ (organization running log)				
(8) how well bottom plugged <u>BW</u> <u>2x10</u>				
DRILLERS REMARKS:				

JUN 4 1970

MISS. SD. OF
 W. I. M.

If well telescopes please sketch and show depths.

GROUND LEVEL

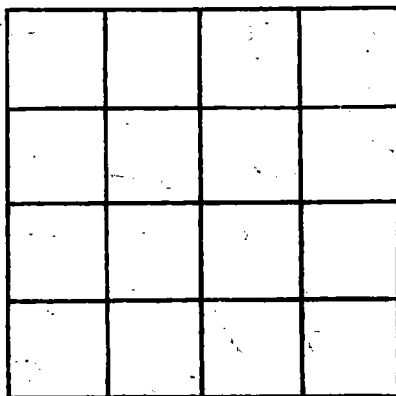

SECTION _____

Please indicate well location X.

ADDITIONAL INFORMATION

If more than one screen, show locations of each on sketch.