

HARRISON
L265
9-27-70

MISSISSIPPI
 BOARD OF WATER COMMISSIONERS
 416 North State Street
 Jackson, Mississippi 39201

FLOR # 81

WATER WELL DRILLERS LOG

CODED

Harrison

9-27-1970 Sutter Well Works
 date well completed firm name county well located

LANDOWNER: <u>Orange Grove Utilities</u>	description of formations encountered	from	to
Gulfport, Miss. (mailing address)	Clay	0	12
	Sand	12	56
	Clay	56	88
WELL LOCATION:	Sand	88	114
sec. <u>3</u> T. <u>7</u> N. R. <u>11</u> E.	Clay-sand streaks	114	628
3 miles SE of Lyman	Sand	628	747
(distance) (direction) (nearest town)			
WELL PURPOSE: <u>sub-division</u>			
(home, irrigation, municipal, industrial)			
WELL COMPLETION DATA:			
(1) diameter (inches) <u>12" x 8"</u>			
(2) total depth (feet) <u>747'</u>			
(3) static water level (feet) <u>38'</u> below above top of ground.			
(4) casing <u>blk. steel 697'</u>			
(material) (depth)			
<u>12" & 8"</u> if telescope see back.			
(size)			
(5) screen <u>50'</u> <u>697'</u>			
(length) (depth to top)			
<u>8"</u> <u>stainless steel</u>			
(size) (material)			
(6) pump <u>20</u> <u>250-300</u>			
(HP) (yield gpm)			
<u>elec.</u>			
(type power)			
(7) electric log <u>yes</u>			
(yes or no)			
<u>U.S.G.S.</u>			
(organization running log)			
(8) how well bottom plugged <u>B.P. Valve</u>			
DRILLERS REMARKS:			

CODED

OCT 19 1970

MISS. Bd. OF WATER COMM.


If well telescopes please sketch and show depths.

GROUND LEVEL

126' of 12" black

570' of 8" black

50' of screen 8"

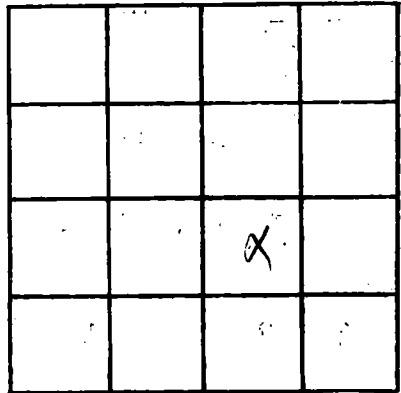

SECTION 3

Please indicate well location X.

ADDITIONAL INFORMATION

If more than one screen, show locations of each on sketch.