

HARRISON
L213

9-2-70

MISSISSIPPI
BOARD OF WATER COMMISSIONERS
416 North State Street
Jackson, Mississippi 39201

CODED

WATER WELL DRILLERS LOG

9/2 date well completed 30 Coastal Drilling Co. firm name Panola county well located

LANDOWNER: J.H. Smith

Rt 3

Gulfport Miss
(mailing address)

WELL LOCATION:

sec 3 T 7 N R 11 E
(2) 1/2 miles NE of London
(distance) (direction) (nearest town)

WELL PURPOSE: home
(home, irrigation, municipal, industrial)

WELL COMPLETION DATA:

- (1) diameter (inches) 2 1/2
- (2) total depth (feet) 469
- (3) static water level (feet) 24 below top of ground
- (4) casing glass 454
(material) (depth)
- (5) screen 151 454
(length) (depth to top)
2 1/2 55
(size) (material)
- (6) pump 2 HP 22
(HP) (yield gpm)
Elec
(type power)
- (7) electric log NO
(yes or no)

(organization running log)

(8) how well bottom plugged
20' below casing

DRILLERS REMARKS: None

description of formations encountered

from to


top soil	1	4
Red clay	4	16
white sand	16	44
hard blue clay	44	296
fine water sand	296	304
coarse water sand	304	319
hard blue clay	319	420
fine water sand	420	435
coarse water sand	435	469

CODED

SEP 30 1970

If well telescopes please sketch and show depths.

GROUND LEVEL

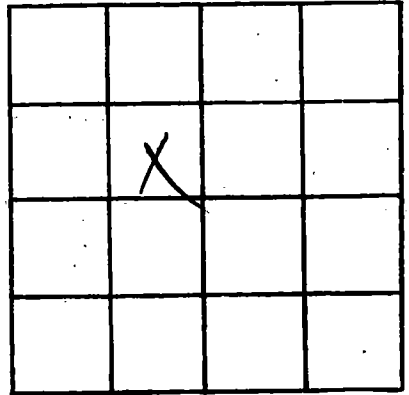

SECTION _____

Please indicate well location X.

ADDITIONAL INFORMATION

If more than one screen, show locations of each on sketch.