

HARRISON
L 281
11-19-70

**MISSISSIPPI
 BOARD OF WATER COMMISSIONERS
 416 North State Street
 Jackson, Mississippi 39201
 WATER WELL DRILLERS LOG**

CODED

11-19-70 1970 R. J. Moore HARRISON
 date well completed firm name county well located

LANDOWNER: OTIS BARMAN
RT 2 ROBINSON RD
Gulfport,
 (mailing address)

WELL LOCATION:
 sec. 6 T. 7 N. R. 11 E
 (S) (W)
2 miles W of NUSENT
 (distance) (direction) (nearest town)

WELL PURPOSE:
 (home, irrigation, municipal, industrial)

- WELL COMPLETION DATA:**
- (1) diameter (Inches) 2"
 - (2) total depth (feet) 405'
 - (3) static water level (feet) 38' below above top of ground.
 - (4) casing S&W 390'
 (material) (depth)
 (size) if telescope see back.
 - (5) screen 2x10 390'
 (length) (depth to top)
2" SS
 (size) (material)
 - (6) pump 1 8
 (HP) (yield gpm)
6
 (type power)
 - (7) electric log yes or no
 (organization running log)
 - (8) how well bottom plugged BW
shale

description of formations encountered	from	to
TOP SOIL	0	10
WHITESAND	10	18
WHITE clay	18	60
Blue clay	60	180
FINE SAND	180	200
Blue clay	200	370
GRAY SAND	370	405

CODED


DEC 13 1970

LUSK RD. W. WATER METER

DRILLERS REMARKS:

If well telescopes please sketch and show depths.

GROUND LEVEL

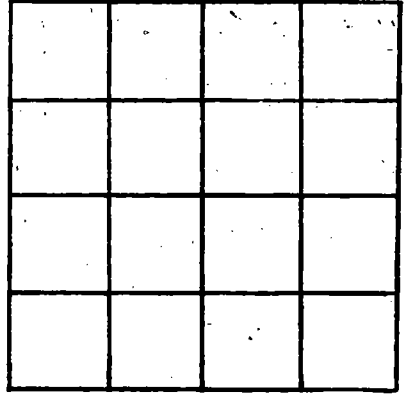

SECTION _____

Please indicate well location X.

ADDITIONAL INFORMATION

If more than one screen, show locations of each on sketch.