

HARRISON
L282
12-8-70

MISSISSIPPI
 BOARD OF WATER COMMISSIONERS
 416 North State Street
 Jackson, Mississippi 39201
 WATER WELL DRILLERS LOG

CODED

12-8-70 19
 date well completed

RT Moore
 firm name

HARRISON
 county well located

LANDOWNER: B.P. WERNER

description of formations encountered

from

to

RT #

GULFPORT, MISS
 (mailing address)

WELL LOCATION:

sec. 5 T. 2 N. R. 11 E.
MY LIP + PLUMKETT RD
NUSENT of IN NUSANT
 (distance) (direction) (nearest town)

WELL PURPOSE:

(home, Irrigation, municipal, Industrial)

WELL COMPLETION DATA:

- (1) diameter (inches) 2"
- (2) total depth (feet) 387
- (3) static water level (feet) 58' ^{below} above top of ground.
- (4) casing steel, 377'
 (material) (depth)
 (size) If telescope see back.
- (5) screen 2x10, 377'
 (length) (depth to top)
2", SS
 (size) (material)
- (6) pump 1, 10
 (HP) (yield gpm)
E
 (type power)
- (7) electric log yes or no
 (organization running log)
- (8) how well bottom plugged Yes
UPHAE

DRILLERS REMARKS: _____

CODED


DEC 7 5 1970

MISS. Bd. of
 WATER COMMISSIONERS

description of formations encountered	from	to
TOP SOIL	0	10
Red Sand	10	30
White Clay	30	70
Red Sand	70	105
Blue Clay	105	240
Red Sand	240	245
Blue Clay	245	360
Blue Sand	360	387

If well telescopes please sketch and show depths.

GROUND LEVEL

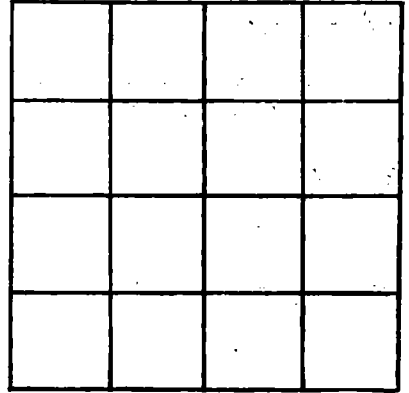

SECTION _____

Please indicate well location X.

ADDITIONAL INFORMATION

If more than one screen,
show locations of each on sketch.