

6/30/69
Returned for F&R

Jarvis
L289
4-19-69

MISSISSIPPI
BOARD OF WATER COMMISSIONERS
416 North State Street
Jackson, Mississippi 39201

CODED

WATER WELL DRILLERS LOG

APRIL 19 1969 McGILL HARRISON
date well completed firm name county well located

LANDOWNER: MARGARET

A. FAXARD

P.O. BOX 7264
GULFPORT (mailing address)

description of formations encountered

from to

TOP SOIL
SAND

0 3
3 30

WELL LOCATION:

sec. 29 T 8 N R 11 E

2 miles E of GULFPORT
(distance) (direction) (nearest town)

CODED

WELL PURPOSE:

(home, irrigation) municipal, industrial

WELL COMPLETION DATA:

- (1) diameter (inches) 1 1/4
- (2) total depth (feet) 30
- (3) static water level (feet) 4 below top of ground.
- (4) casing ~~metal~~ (material) (depth) (size) if telescope see back.
- (5) screen 5' (length), 25 (depth to top), 2 (size), SS (material)
- (6) pump 1 (HP), 18 (yield gpm)
- Elec (type power)
- (7) electric log NO (yes or no)

(organization running log)

(8) how well bottom plugged BW.


JUN 30 1969

DRILLERS REMARKS:

MISS. BD. OF
WATER COMM.

If well telescopes please sketch and show depths.

GROUND LEVEL

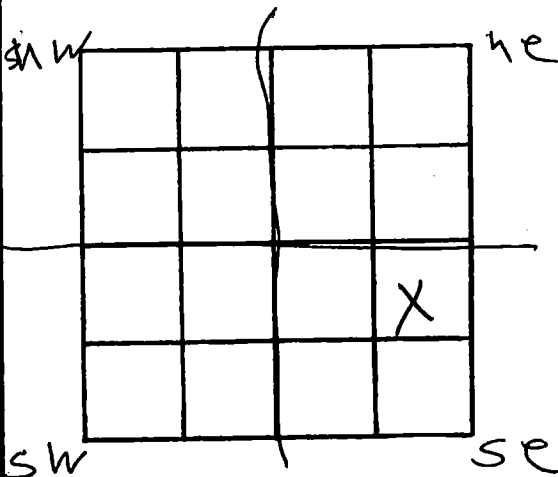

SECTION 29

Please indicate well location X.

ADDITIONAL INFORMATION

If more than one screen, show locations of each on sketch.