

① L292 6397313

10-9-63

WATER WELL DRILLERS LOG

CODED

Date: Oct 9, 1963, Driller: Hattiesburg Butte County Harrison
 (Name)

(1) Owner of Land: L. L. Rowe
 (Name)
Rt 2 Geyport, Miss
 (Address)

(2) Location: 1/4, 1/4, Sec 4 T 7 R 11
Way 49 N.
 miles _____ of _____
 (distance) (direction) (Nearest Town)

(3) Topography: Level
 (Hilly) (Flat) (Level)

(4) Purpose of Well: domestic
 (Domestic Irrigation
 Municipal, Industrial, Other)

Description & Color of Materials Sand, Clay, Red Clay, Shell, etc.	Thick- ness Feet	Depth Feet
<u>Red clay</u>	<u>0-8</u>	
<u>Red sand</u>	<u>8-18</u>	
<u>white sand</u>	<u>18-40</u>	
<u>white clay</u>	<u>40-60</u>	
<u>Blue clay</u>	<u>60-70</u>	
<u>Blue sand</u>	<u>70-110</u>	
<u>Blue clay</u>	<u>110-230</u>	
<u>Blue sand</u>	<u>230-234</u>	
<u>Blue clay</u>	<u>234-388</u>	
<u>Blue sand</u>	<u>388</u>	<u>410</u>

Information upon completion of well:

(1) Diameter 2 inches.


(2) Total Depth 410 feet.

(3) Water Level 18 feet below top of ground.

(4) Cased to _____, Size _____

(5) Screen: Size 2", Length 10'

(6) Were any formations sealed against pollution?
 _____ yes, _____ no.

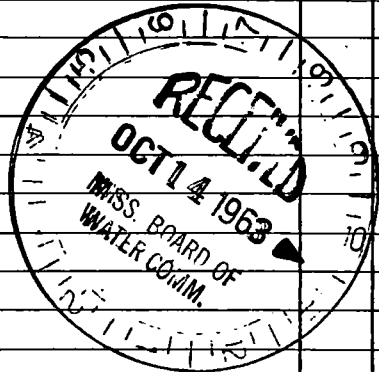

CODED

If YES depth of formation _____

Why _____

Drillers Remarks: _____

(Use Back Side)

Well No.

1943

1943

1943

1943