

HAR.

MISSISSIPPI BOARD OF WATER COMMISSIONERS

293 K364912

CODED(?)

2-17-62

WATER WELL DRILLERS LOG

Date: 2-17, 1962, Driller: M&B Drilling Co. County: Harrison

(Name)

(1) Owner of Land: Marvin Head
 (Name)
Three Rivers Rd. Gulfport Miss
 (Address)
7 mile N. Junction Orleans Rd & R 11
 (2) Location: Three Rivers, Del.
6 miles North, of Gulfport
 (distance) (direction) (Nearest Town)
 (3) Topography: Flat
 (Hilly) (Flat) (Level)
 (4) Purpose of Well: Home
 (Domestic Irrigation
 Municipal, Industrial, Other)


Description & Color of Materials Sand, Clay, Red Clay, Shell, etc.	Thick- ness Feet	Depth Feet
Clay	4	4
White chalk Clay	4	8
White Clay	22	30
Silt & Sand	60	90
Blue Clay	65	155
Grey Sand	3	158
Blue Clay	47	207
Fine Grey Sand	11	218
Blue Clay	52	270
Medium Grey Sand	22	292
Blue Clay	78	370
Fine Grey Sand	8	378
Sand & Clay Breaks		
Blue Clay	12	390
Sand & Clay Breaks	50	440
Blue Clay	50	490
Rock	1	491
Blue Clay	55	546
Fine Sand	9	555
Blue Clay	95	650
Sand, fine	30	680
Medium Sand	30	710
Coarse Sand	20	730
Fine Sand	5	735
Blue Clay	5	735

Information upon completion of well:


(1) Diameter 2 inches.
 (2) Total Depth 714 feet.
 (3) Water Level 14 feet below top of ground.
 (4) Cased to 704, Size 2"
 (5) Screen: Size 8/16", Length 10 FT.
 (6) Were any formations sealed against pollution?
 _____ yes, _____ no.

If YES depth of formation _____
Why _____

Drillers Remarks: Tried to make a well in Sand at 270-292, but too much fine sand as it seals off. S Trainer.

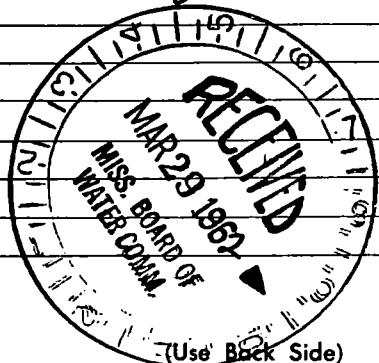

Well No.

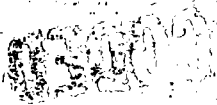


515

Vertical text on the left side of the page, possibly a list or index, with some numbers and names.

Main body of text in the upper left quadrant, consisting of several lines of handwritten or printed text.

Text in the upper right quadrant, including a large number '7' and other illegible characters.

Text in the lower right quadrant, appearing to be a list or set of instructions.

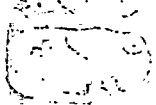

Text at the bottom of the page, possibly a footer or concluding remarks, including some numbers and names.