

HAR.

MISSISSIPPI BOARD OF WATER COMMISSIONERS

K349

L299 U364005

WATER WELL DRILLERS LOG

CODED

9-1-61

Date: 9-1, 1961, Driller: Hattisburg Butts County Harrison

(Name)

(1) Owner of Land: Louis Crawford (Name)

Hubert, Miss (Address)

(2) Location: 1/4, 1/4, Sec 18 T 7 R 11

6 miles NW of Hubert (distance) (direction) (Nearest Town)

(3) Topography: (Hilly) (Flat) (Level)

(4) Purpose of Well: Domestic (Domestic Irrigation Municipal, Industrial, Other)

Description & Color of Materials Sand, Clay, Red Clay, Shell, etc.	Thick- ness Feet	Depth Feet
red sand	0	40
white clay	40	70
Blue clay	70	95
Blue sand	95	125
Blue clay	125	180
Blue sand	180	200

Information upon completion of well:

(1) Diameter 2 inches.

(2) Total Depth 200 feet.

(3) Water Level 30 feet below top of ground.

(4) Cased to, Size

(5) Screen: Size 2", Length 10'

(6) Were any formations sealed against pollution?


yes, X no.

If YES depth of formation

Why

Drillers Remarks:

CODED

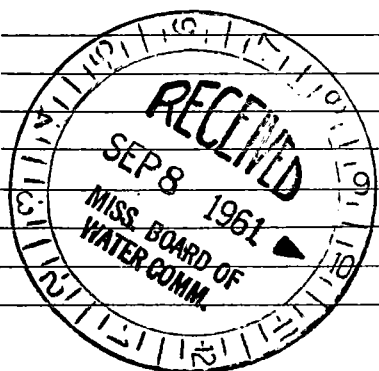

(Use Back Side)

Well No.

1000