

HARRISON

L 296

1-30-71

MISSISSIPPI BOARD OF WATER COMMISSIONERS  
416 North State Street  
Jackson, Mississippi 39201

**CODED**

WATER WELL DRILLERS LOG

1/30 date well completed

1971 Pineville well wks firm name

HARRISON county well located

LANDOWNER: NORMAN Cowart

description of formations encountered

from

to

Theremin Rd

Gulfport Miss  
(mailing address)

Hard top clay

0

8'

WELL LOCATION:

sec 5 T 7 R 11 S W  
3 miles N of Landon  
(distance) (direction) (nearest town)

Sand & pea gravel

8'

28'

WELL PURPOSE: HOME  
(home, irrigation, municipal, industrial)

Soft white clay

28'

220'

WELL COMPLETION DATA:

fine powder sand

220'

235'

(1) diameter (inches) 2"  
(2) total depth (feet) 519  
(3) static water level (feet) 28' below top of ground.

Hard Blue clay or Pipe clay

235'

478'

(4) casing gal pipe, 514' (material) (depth)  
2" (size) if telescope see back.

Coarse sand gap

478'

519'

(5) screen 5' 514' (length) (depth to top)  
2" (size) All S.S. (material)

4' I used a 12 slot screen.

Could not use a 14 slot if I had one.

(6) pump 1 (HP) 985 GPH (yield gpm)

**CODED**

E/EC (type power)

(7) electric log No (yes or no)

M/A (organization running log)


(8) how well bottom plugged and

DRILLERS REMARKS:

MAR 9 - 1971  
MISS. BD. OF WATER COMM.

If well telescopes please sketch and show depths.

GROUND LEVEL

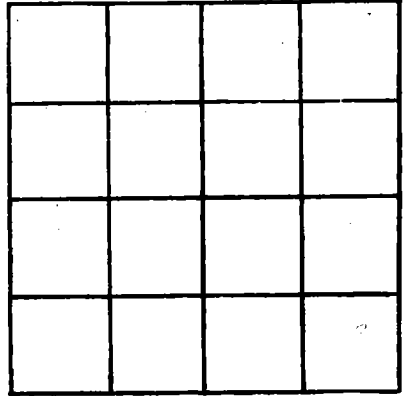

SECTION \_\_\_\_\_

Please indicate well location X.

ADDITIONAL INFORMATION

If more than one screen, show locations of each on sketch.