

HAR.
L 298
1-19-62

MISSISSIPPI OF WATER COMMISSIONERS

WATER WELL DRILLERS LOG **CODED?**

Date: Jan 19, 1962, Driller: C. T. SWITZER WELL CO. County: Harrison
(Name)

(1) Owner of Land: Dr. H. J. Sheffield
(Name)
Rt. 1 Box 135 Hafford, Miss
(Address)

(2) Location: 1/4, 1/4, Sec. 7 T 1 R 1
_____ miles _____ of _____
(distance) (direction) (Nearest Town)

(3) Topography: X
(Hilly) (Flat) (Level)

(4) Purpose of Well: Domestic
(Domestic Irrigation
Municipal, Industrial, Other)

Description & Color of Materials Sand, Clay, Red Clay, Shell, etc.	Thick- ness Feet	Depth Feet
Clay	00	17
Sand	17	21
Sand & gravel	21	41
Sand	41	91
Clay	91	101
Clay sand streaks	101	141
Clay	141	161
Streaks	161	181
Clay	181	185
Sand	185	201
Clay	201	221
Clay sand streaks	221	241
Sand	241	247
Clay	247	251
Sand	251	281
Sand, fine	281	287

Information upon completion of well:

(1) Diameter 3x2 inches.

(2) Total Depth 285' feet.

(3) Water Level 31' feet below top of ground.

(4) Cased to 285', Size 3x2

(5) Screen: Size 3x2, Length 10'


(6) Were any formations sealed against pollution?
X yes, _____ no.

If YES depth of formation _____

Why Health Dept. Requirement

Drillers Remarks: _____

CODED

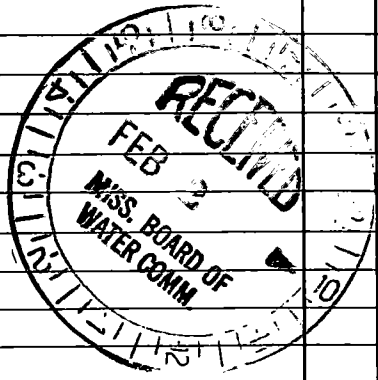

(Use Back Side)

Well No.

WATER WELL DRILLERS LOG

Date: 10/10/19 Driller: H. H. H.

Depth (feet)	Description of Soil or Rock	Remarks
0	Surface	
1	Topsoil	
2	Loam	
3	Clay	
4	Sand	
5	Gravel	
6	Shale	
7	Limestone	
8	Coal	
9	Marl	
10	Clay	
11	Sand	
12	Gravel	
13	Shale	
14	Limestone	
15	Coal	
16	Marl	
17	Clay	
18	Sand	
19	Gravel	
20	Shale	
21	Limestone	
22	Coal	
23	Marl	
24	Clay	
25	Sand	
26	Gravel	
27	Shale	
28	Limestone	
29	Coal	
30	Marl	
31	Clay	
32	Sand	
33	Gravel	
34	Shale	
35	Limestone	
36	Coal	
37	Marl	
38	Clay	
39	Sand	
40	Gravel	
41	Shale	
42	Limestone	
43	Coal	
44	Marl	
45	Clay	
46	Sand	
47	Gravel	
48	Shale	
49	Limestone	
50	Coal	
51	Marl	
52	Clay	
53	Sand	
54	Gravel	
55	Shale	
56	Limestone	
57	Coal	
58	Marl	
59	Clay	
60	Sand	
61	Gravel	
62	Shale	
63	Limestone	
64	Coal	
65	Marl	
66	Clay	
67	Sand	
68	Gravel	
69	Shale	
70	Limestone	
71	Coal	
72	Marl	
73	Clay	
74	Sand	
75	Gravel	
76	Shale	
77	Limestone	
78	Coal	
79	Marl	
80	Clay	
81	Sand	
82	Gravel	
83	Shale	
84	Limestone	
85	Coal	
86	Marl	
87	Clay	
88	Sand	
89	Gravel	
90	Shale	
91	Limestone	
92	Coal	
93	Marl	
94	Clay	
95	Sand	
96	Gravel	
97	Shale	
98	Limestone	
99	Coal	
100	Marl	

(1) Owner of Well: John Doe
 (2) Location: N. Sec. 1, T. 1, R. 1
 (3) Topography: Level
 (4) Purpose of Well: Domestic

Information upon completion of well:
 (1) Diameter: 4 inches
 (2) Total Depth: 100 feet
 (3) Water Level: 10 feet below top of ground
 (4) Cased to: 10 feet
 (5) Screen Size: 1/2 inch length
 (6) Were any formations sealed against pollution? no
 If YES: depth of formation 10 feet
 Driller's Remarks: Well completed