

HAR.

MISSISSIPPI BOARD OF WATER COMMISSIONERS

L301
2-64

WATER WELL DRILLERS LOG

CODED

Date: Feb, 1964, Driller: Joe Miller County Harrison
(Name)

(1) Owner of Land: Paris Evans
(Name)
Rifeys Road, Mt Sulfur
(Address)
127 4 11

(2) Location: 1/4, 1/4, Sec. T R
2 miles North of Sulfur
(distance) (direction) (Nearest Town)

(3) Topography: Flat
(Hilly) (Flat) (Level)

(4) Purpose of Well: Domestic
(Domestic Irrigation
Municipal, Industrial, Other)

Description & Color of Materials Sand, Clay, Red Clay, Shell, etc.	Thick- ness Feet	Depth Feet
<u>Surface</u>	<u>8</u>	<u>8</u>
<u>Clay, Clay</u>	<u>10</u>	<u>18</u>
<u>White Sand</u>	<u>7</u>	<u>25</u>
<u>Blue Clay</u>	<u>130</u>	<u>155</u>
<u>Fine Blue Sand</u>	<u>17</u>	<u>172</u>
<u>Blue Clay</u>	<u>10</u>	<u>182</u>
<u>Sand Blue Fine</u>	<u>8</u>	<u>190</u>
<u>Sand, Blue Clay</u>	<u>10</u>	<u>200</u>
<u>Fin</u>	<u>8</u>	<u>208</u>
<u>Hard Blue Clay</u>	<u>2</u>	<u>210</u>

Information upon completion of well:

(1) Diameter 2" inches.

(2) Total Depth 210 feet.

(3) Water Level 7' feet below top of ground.

(4) Cased to 198', Size 2"

(5) Screen: Size 2", Length 10'


(6) Were any formations sealed against pollution?
_____ yes, _____ no.

CODED

If YES depth of formation _____

Why _____

Drillers Remarks: _____

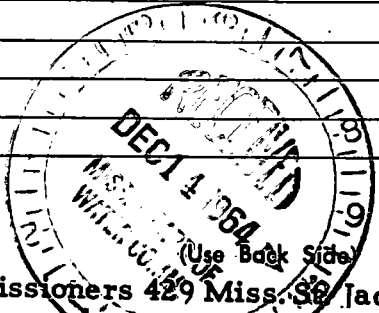

Well No.

