

HAR.

MISSISSIPPI BOARD OF WATER COMMISSIONERS

L303

5-64

WATER WELL DRILLERS LOG

CODED

Date May, 1964, Driller: Joe Miller County Harrison
(Name)

(1) Owner of Land Charlie Frauley
(Name)

RR# Sulphur
(Address)
167 7 11

(2) Location: 1/4, 1/4, Sec. T R

1 miles North of Sulphur
(distance) (direction) (Nearest Town)

(3) Topography: Flat
(Hilly) (Flat) (Level)

(4) Purpose of Well: Commercial
(Domestic Irrigation
Municipal, Industrial, Other)

Description & Color of Materials Sand, Clay, Red Clay, Shell, etc.	Thick- ness Feet	Depth Feet
<u>Fill</u>	<u>2</u>	<u>2</u>
<u>Surface</u>	<u>6</u>	<u>8</u>
<u>Blue Clay</u>	<u>22</u>	<u>30</u>
<u>White Sand & Wood</u>	<u>40</u>	<u>70</u>
<u>Blue Clay</u>	<u>20</u>	<u>90</u>
<u>Fine Grey sand</u>	<u>36</u>	<u>126</u>
<u>Grey sand (Little Red)</u>	<u>17</u>	<u>143</u>
<u>Blue Clay</u>	<u>52</u>	<u>195</u>
<u>Fine Grey sand</u>	<u>15</u>	<u>210</u>
<u>Grey sand (Good)</u>	<u>46</u>	<u>256</u>

Information upon completion of well:

(1) Diameter 2" inches.

(2) Total Depth 256 feet.

(3) Water Level 10 1/2" feet below top of ground.

(4) Cased to 242, Size 2"

(5) Screen: Size 2', Length 10'

(6) Were any formations sealed against pollution?
_____ yes, _____ no.


If YES depth of formation _____

Why _____

Drillers Remarks: _____

Well in Sand.

CODED

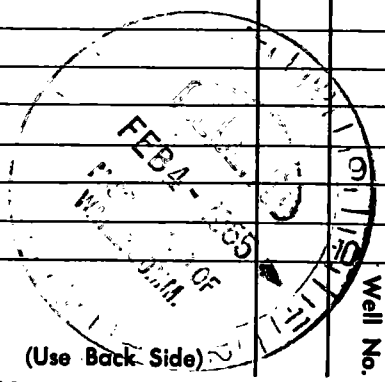

over

(Use Back Side)

Well No.

2003

