

HAR. MISSISSIPPI BOARD OF WATER COMMISSIONERS

L304
5-21-64

U 397813

WATER WELL DRILLERS LOG

CODED

Date: 5-21, 1964, Driller: Hattisburg Butte County Harrison
(Name)

(1) Owner of Land: G. C. Reeves, Sr
(Name)
Shuffort, Miss
(Address)
5711
(2) Location: 1/4, 1/4, Sec. T. R.
N. County Farm Rd
miles of (Nearest Town)
(distance) (direction)
(3) Topography: X
(Hilly) (Flat) (Level)
(4) Purpose of Well: domestic
(Domestic Irrigation
Municipal, Industrial, Other)


Description & Color of Materials Sand, Clay, Red Clay, Shell, etc.	Thick- ness Feet	Depth Feet
<u>Red sand</u>	<u>0-15</u>	
<u>white clay</u>	<u>15-40</u>	
<u>Blue clay</u>	<u>40-150</u>	
<u>Blue sand</u>	<u>150-170</u>	

Information upon completion of well:

(1) Diameter 2 inches.
(2) Total Depth 170 feet.
(3) Water Level 73 feet below top of ground.
(4) Cased to _____, Size _____
(5) Screen: Size 2", Length 10'
(6) Were any formations sealed against pollution?
_____ yes, X no.

CODED

If YES depth of formation _____
Why _____
Drillers Remarks: _____

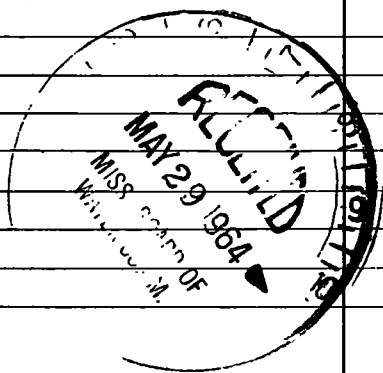

(Use Back Side)

Well No.

0000