

HAR.

MISSISSIPPI BOARD OF WATER COMMISSIONERS

L305

WATER WELL DRILLERS LOG

CODED

8-12-64

K & 401 808

Date: 8-12, 1964, Driller: C. T. SWITZER WELL CO County Harrison

(Name)

(1) Owner of Land: H. E. GINN  
R. F. D. Gulfport Miss  
1/2 mile south of Bolins Dairy  
on Thru (Address) River

(2) Location: 1/4, 1/4, Sec. 3 T7R11  
miles (distance) of (Nearest Town)

(3) Topography: (Hilly) (Flat) (Level)

(4) Purpose of Well: Domestic  
(Domestic Irrigation, Municipal, Industrial, Other)

Description & Color of Materials Sand, Clay, Red Clay, Shell, etc.	Thick- ness Feet	Depth Feet
Clay	00	14
Sand	14	26
Clay	26	74
Sand	76	84
Sand, good	84	105
Sand	105	120
Clay	120	126
Clay + sand sika	126	148
Clay	148	210
Sand	210	231
Sand + Clay sika	231	252
Sand, good	252	270

Information upon completion of well:

(1) Diameter 2" inches.

(2) Total Depth 270' feet.

(3) Water Level 21 - feet below top of ground.

(4) Cased to 270', Size 2"

(5) Screen: Size 2", Length 10'

(6) Were any formations sealed against pollution?


X yes, no.

If YES depth of formation.

Why Health Dept Requirements

Drillers Remarks:

CODED

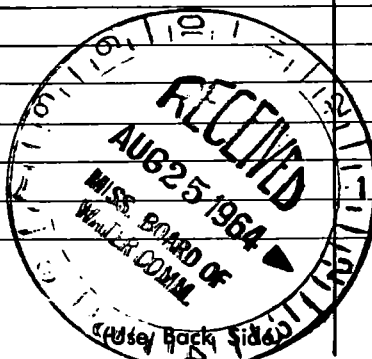

Well No.

1950