

L308
3-25-66

WATER WELL DRILLERS LOG

CODED

Date: Nov 25, 1966, Driller: Joe Miller County Harrison
March (Name)

(1) Owner of Land: R O Neal
(Name)
RR # Gulfport
(Address)

(2) Location: 1/4, 1/4, Sec. 11 7 11 R
1 miles North of Gulfport
(distance) (direction) (Nearest Town)

(3) Topography: Flat
(Hilly) (Flat) (Level)

(4) Purpose of Well: Domestic
(Domestic Irrigation
Municipal, Industrial, Other)

Description & Color of Materials Sand, Clay, Red Clay, Shell, etc.	Thick- ness Feet	Depth Feet
Red & Brown Clay	5	5
White Sand	3	8
Dark Blue Clay	12	20
Coarse White Sand	6	26
Hard Blue Clay	44	70
Sand. Gray, Fine	14	84
" "	11	95
" " Little Bots	11	106
" " Fair	13	119
Hard Blue Clay	3	122

Information upon completion of well:

(1) Diameter 2" inches.

(2) Total Depth 122' feet.

(3) Water Level Flowing 3' Head feet below top of ground.

(4) Cased to 109, Size 2"

(5) Screen: Size 2", Length 10'

(6) Were any formations sealed against pollution?
_____ yes, _____ no.


Used 5' Jail
Pipe

CODED

If YES depth of formation _____

Why _____

Drillers Remarks: _____

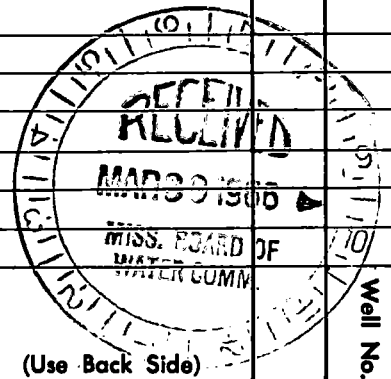

(Use Back Side)

Well No.

0000