

HAR.

MISSISSIPPI BOARD OF WATER COMMISSIONERS

L 311

354301

WATER WELL DRILLERS

**CODED**

316

3-21-61

Date: 3-21, 1961, Driller: C. T. Switzer Well Co County Jefferson  
(Name)

(1) Owner of Land: Ray H. Miller  
(Name)

Box 100-F Rt 2, Gulfport, Miss  
(Address)

(2) Location: 4/9 Sec. 21 T. R,  
9/7 of 11  
(distance) (direction) (Nearest Town)

(3) Topography: ✓  
(Hilly) (Flat) (Level)

(4) Purpose of Well: Domestic  
(Domestic Irrigation  
Municipal, Industrial, Other)

| Description & Color of Materials<br>Sand, Clay, Red Clay, Shell, etc. | Thick-<br>ness<br>Feet | Depth<br>Feet |
|---|------------------------|---------------|
| Clay  | 0                      | 5             |
| sand  | 11                     | 16            |
| clay  | 44                     | 55            |
| sand  | 46                     | 101           |
| Clay  | 76                     | 177           |
| sand  | 5                      | 182           |
| yellow sand   | 20                     | 202           |
| Clay  | 121                    | 323           |
| sand  | 72                     | 395           |

Information upon completion of well:

(1) Diameter 2 inches.

(2) Total Depth 396 feet.

(3) Water Level 2' + feet <sup>above</sup> ~~below~~ top of ground.

(4) Cased to 396, Size 2"

(5) Screen: Size 2", Length 10'


(6) Were any formations sealed against pollution?  
✓ yes,        no.

**CODED**

If YES depth of formation 10 ft -

Why Health Dept. Requirement

Drillers Remarks: \_\_\_\_\_

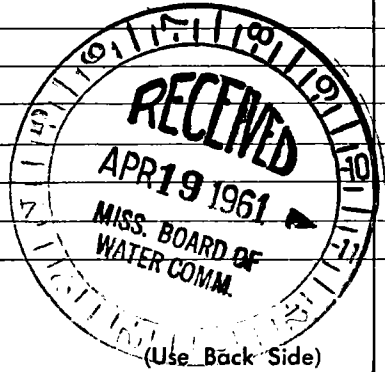

Well No.

A - B - D - C - W

VPE

#10

240

120

Enclosure of the ...