

MISSISSIPPI BOARD OF WATER COMMISSIONERS

OL 312
9-18-61

6172934

WATER WELL DRILLERS LOG

CODED

L7
A300
347

Date: 9-18, 1961, Driller: Sutton Well Works County Harrison
(Name)

(1) Owner of Land: Gulf Park Lanes
(Name)
Mississippi City, Miss.
(Address)

(2) Location: 36 7 11 W R
1/4, 1/4 Sec. T R
IN miles, W (direction), of M.C. (Nearest Town)
(distance)

(3) Topography: flat
(Hilly) (Flat) (Level)

(4) Purpose of Well: Industrial
(Domestic Irrigation
Municipal, Industrial, Other)

Description & Color of Materials Sand, Clay, Red Clay, Shell, etc.	Thick- ness Feet	Depth Feet
<u>Sand</u>	<u>70</u>	<u>70</u>
<u>Clay</u>	<u>110</u>	<u>180</u>
<u>soft clay - sand streak</u>	<u>520</u>	<u>700</u>
<u>Sand</u>	<u>40</u>	<u>740</u>
<u>Clay</u>	<u>8</u>	<u>748</u>
<u>sand</u>	<u>39</u>	<u>787</u>

Information upon completion of well:

(1) Diameter 4 inches.

(2) Total Depth 787 feet.

(3) Water level 4 feet below top of ground.

(4) Cased to cell, Size 4"

(5) Screen: Size 4", Length 20'


(6) Were any formations sealed against pollution?
no yes, no.

If YES depth of formation _____

Why _____

Drillers Remarks: _____

CODED

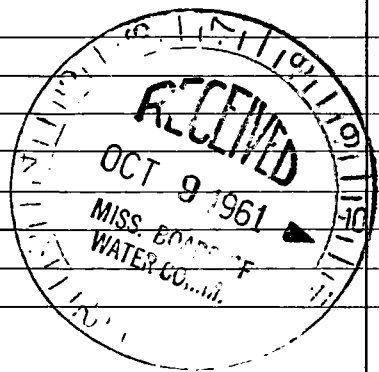

(Use Back Side)

Well No.

1950

1000
1000
