

HAR.

MISSISSIPPI BOARD OF WATER COMMISSIONERS

L314

6-21-62

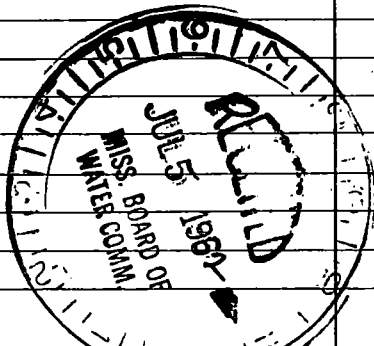
WATER WELL DRILLERS

CODED

(?)

Date: 6-21, 1962, Driller: C. T. SWITZER WELL CO. County: Harrison

(Name)

	Description & Color of Materials Sand, Clay, Red Clay, Shell, etc.	Thick- ness Feet	Depth Feet
(1) Owner of Land: <u>Robert H. Sault</u> (Name) <u>1310 Mill St. Hammond</u> (Address)	Clay	00	15
	Sand	15	20
(2) Location: <u>1/4</u> , <u>1/4</u> , Sec. <u>24 71A</u>	Sand & Gravel	20	60
	Sand	60	70
_____ miles _____ of _____	Clay	70	100
(distance) (direction) (Nearest Town)	Sand, red	100	140
(3) Topography: <input checked="" type="checkbox"/> (Hilly) <input type="checkbox"/> (Flat) <input type="checkbox"/> (Level)	Clay	140	160
(4) Purpose of Well: <u>Domestic</u>	Sand, fine	160	180
(Domestic Irrigation Municipal, Industrial, Other)	Clay	180	252
Information upon completion of well:	Sand	252	260
(1) Diameter <u>2 1/2</u> inches.	Sand, fine	260	300
(2) Total Depth <u>610</u> feet.	Clay	300	320
(3) Water Level <u>9' 5"</u> feet below top of ground.	Sand, fine	320	318
(4) Cased to <u>610'</u> , Size <u>2 1/2"</u>	Clay	340	420
(5) Screen: Size <u>2 1/2"</u> , Length <u>10'</u>	Sand, fine	420	480
(6) Were any formations sealed against pollution?	Clay	490	585
<input checked="" type="checkbox"/> yes, <input type="checkbox"/> no.	Sand	535	540
If YES depth of formation _____	Sand, gravel	540	610
Why <u>Health Dept. Requirements</u>	CODED		
Drillers Remarks: _____			
_____	(Use Back Side)		

Well No.

