

HAR.
 L 317
 10-30-63

WATER WELL DRILLERS LOG **CODED**

Date: 10-30, 1963, Driller: C. T. SWITZER WELL CO. County Madison
 (Name)

(1) Owner of Land: Harold A. Branch
 (Name)
Branch Cleaners - Pass Rd
 (Address)
 (2) Location: 1/4, 1/4, Sec. T R
36? 7 11
 miles of
 (distance) (direction) (Nearest Town)
 (3) Topography: (Hilly) (Flat) (Level)
 (4) Purpose of Well: Commercial
 (Domestic Irrigation
 Municipal, Industrial, Other)


Description & Color of Materials Sand, Clay, Red Clay, Shell, etc.	Thick- ness Feet	Depth Feet
<u>sand</u>	<u>00</u>	<u>31</u>
<u>clay</u>	<u>31</u>	<u>88</u>
<u>sand & gravel</u>	<u>58</u>	<u>110</u>
<u>sand & clay silt</u>	<u>110</u>	<u>190</u>
<u>clay</u>	<u>130</u>	<u>145</u>
<u>sand</u>	<u>145</u>	<u>179</u>
<u>clay</u>	<u>179</u>	<u>235</u>
<u>sand, fine</u>	<u>235</u>	<u>242</u>
<u>sand</u>	<u>242</u>	<u>252</u>
<u>clay</u>	<u>252</u>	<u>415</u>
<u>shell</u>	<u>415</u>	<u>499</u>
<u>shell w/ sand silt</u>	<u>499</u>	<u>542</u>
<u>shell</u>	<u>542</u>	<u>596</u>
<u>shell</u>	<u>596</u>	<u>654</u>
<u>shell</u>	<u>654</u>	<u>730</u>
<u>sand</u>	<u>730</u>	<u>779</u>

Information upon completion of well:

(1) Diameter 3 1/4 inches.
 (2) Total Depth 780 feet.
 (3) Water Level 14' feet below top of ground.
 (4) Cased to 420', Size 3 1/4"
 (5) Screen: Size 3" x 20', Length 20'
 (6) Were any formations sealed against pollution?
 yes, no.

CODED

If YES depth of formation _____
 Why North Dept. requirement
 Drillers Remarks: _____

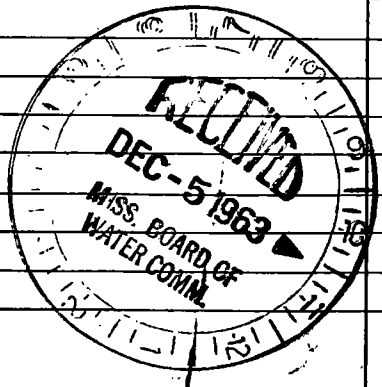

(Use Back Side)

Well No.

