

L321
11-18-63

K 353 502

WATER WELL DRILLERS LOG

CODED

18

Date: Nov 18, 1963, Driller: Hattusburg Butane County, Harrison
(Name)

(1) Owner of Land: James Williams
(Name)
John Q. Adams & Hwy 49
(Address)
(2) Location: North Gulfport
28 7 11
3 miles N of Ept
(distance) (direction) (Nearest Town)
(3) Topography: flat
(Flat) (Level)
(4) Purpose of Well: domestic
(Domestic Irrigation
Municipal, Industrial, Other)


Description & Color of Materials Sand, Clay, Red Clay, Shell, etc.	Thick- ness Feet	Depth Feet
<u>Red sand</u>	<u>0-6</u>	
<u>white sand</u>	<u>6-18</u>	
<u>Blue clay</u>	<u>18-30</u>	
<u>Blue sand</u>	<u>30-60</u>	
<u>Blue clay</u>	<u>60-140</u>	
<u>Blue sand</u>	<u>140-145</u>	
<u>Blue clay</u>	<u>145-200</u>	
<u>Blue sand</u>	<u>200-243</u>	

Information upon completion of well:

(1) Diameter 2 inches.
(2) Total Depth 243 feet.
(3) Water Level 10 feet below top of ground.
(4) Cased to _____, Size _____
(5) Screen: Size 2", Length 12"
(6) Were any formations sealed against pollution?
_____ yes, _____ no.

CODED

If YES depth of formation _____
Why _____
Drillers Remarks: _____

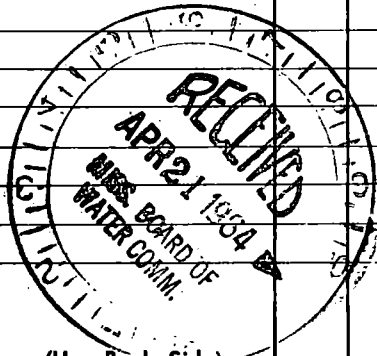

(Use Back-Side)

Well No.

1910

1910

