

L322

3-2-65

B 77205

WATER WELL DRILLERS LOG

CODED

Date: Apr 2, 1965, Driller: Joe Miller County Harrison
 (Name)

(1) Owner of Land: John Graham
 (Name)
Landon P. Sufferd
 (Address)
 (2) Location: 1/4 N 1/4 Sec 7 11
1/4 N 1/4 Sec 7 11
5 miles (distance) N E of Sufferd (Town)
 (3) Topography: Flat
 (Hilly) (Flat) (Level)
 (4) Purpose of Well: Domestic
 (Domestic Irrigation, Municipal, Industrial, Other)

Description & Color of Materials Sand, Clay, Red Clay, Shell, etc.	Thick- ness Feet	Depth Feet
Surface	8	8
Tan Sand	11	19
Red Clay White Clay	4	23
White Sand	6	29
Wh Cl, Red Ch.	18	47
Blue Clay - Sm. Br.	121	168
Blue Clay	64	232
Gray Sand (Fine)	10	242
" " (Fair)	10	252
" " "	8	271
Hard Blue Clay		274

Information upon completion of well:


(1) Diameter 2 inches.
 (2) Total Depth 274 feet.
 (3) Water Level 27' feet below top of ground.
 (4) Cased to 261, Size 2"
 (5) Screen: Size 2", Length 10'
 (6) Were any formations sealed against pollution?
 _____ yes, _____ no.

If YES depth of formation _____
 Why _____

Drillers Remarks: _____

5' lead pipe

CODED

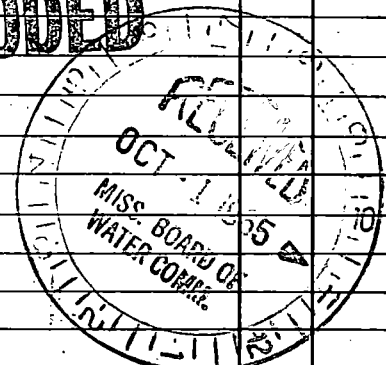

Well No.

(Use Back Side)

02004

S

HKy 49

Canal Rd

John
Graham

Rendon Rd

W

N

E

