

HAR.

MISSISSIPPI BOARD OF WATER COMMISSIONERS

L323

G 243707

CODED

6-16-65

WATER WELL DRILLERS LOG

Date: 6-16, 19 65, Driller: Int'l Well Works County Harrison

(Name)

(1) Owner of Land: James Eaton
 (Name)
Kelly Ave - Gulfport
 (Address)

(2) Location: 1/4, Sec. 3 T8 R11,
Just SW
 miles 1.7 IN of Gulfport
 (distance) (direction) (Nearest Town)

(3) Topography: flat
 (Hilly) (Flat) (Level)

(4) Purpose of Well: domestic
 (Domestic Irrigation
 Municipal, Industrial, Other)

Description & Color of Materials Sand, Clay, Red Clay, Shell, etc.	Thick- ness Feet	Depth Feet
<u>sand</u>	<u>35</u>	<u>35</u>
<u>clay</u>	<u>154</u>	<u>189</u>
<u>fine sand</u>	<u>32</u>	<u>221</u>
<u>clay</u>	<u>16</u>	<u>237</u>
<u>sandy clay</u>	<u>56</u>	<u>293</u>
<u>sand</u>	<u>17</u>	<u>310</u>
<u>Clay</u>	<u>50</u>	<u>360</u>
<u>Clay - sand streaks</u>	<u>44</u>	<u>404</u>

Information upon completion of well:

(1) Diameter 2 x 2 1/2 inches.

(2) Total Depth 310 feet.

(3) Water Level 9 feet below top of ground.

(4) Cased to cell, Size TOP 63'-2 1/2"
BAL. 2"

(5) Screen: Size 2", Length 15'


(6) Were any formations sealed against pollution?
 _____ yes, no.

CODED

If YES depth of formation _____

Why _____

Drillers Remarks: _____

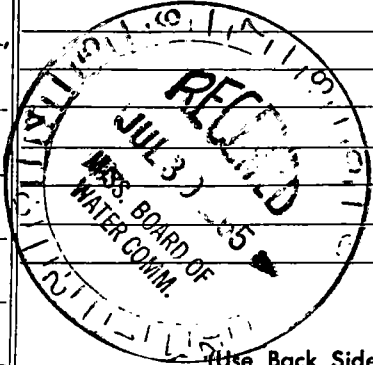

Well No.

1900

Account of the ...

1899
1898
1897
1896
1895
1894
1893
1892
1891
1890

...

...

