

MISSISSIPPI  
BOARD OF WATER COMMISSION  
416 North State Street  
Jackson, Mississippi 39201

**CODED**

WATER WELL DRILLERS LOG

Harrison  
L 324  
11-67

Nov. 17 1967 M & B Drilling Co. Harrison  
date well completed firm name county well located

LANDOWNER:

Lawrence Taylor  
638 East Beach Bulfoot  
(mailing address)

WELL LOCATION:

sec. 2 T. 8 S. R. 11 E.  
Beach Avenue Ave. Bulfoot  
(distance) miles (direction) (nearest town)

WELL PURPOSE: Heating After  
(home, irrigation, municipal, industrial)

WELL COMPLETION DATA:

- (1) diameter (inches) 2
- (2) total depth (feet) 240
- (3) static water level (feet) 6 below top of ground.
- (4) casing PVC 2 1/2" (material) 229 (depth) 5 FT 10 in. piece (size) If telescope see back.
- (5) screen 6 FT 2 1/2" (length) 229 (depth to top) 2" (size) PVC Sand Pac (material)
- (6) pump 1/2 (HP) 20 (yield gpm) 110V 1φ (type power)
- (7) electric log No (yes or no)  
(organization running log)
- (8) how well bottom plugged PVC Cap.

description of formations encountered

	from	to
Surface Sand	0	25
Clay	25	28
Sand	28	35
Blue Clay + Sea Shells	35	50
Sea Shells + Light Green Clay	50	60
Coarse White Sand	60	72
Light Blue Clay	72	97
Sand + Clay Breaks	97	105
Blue Clay	105	115
Sand + Clay Breaks	115	120
Blue Clay	120	130
Shell Bed	130	140
Blue Clay	140	155
Sand	155	160
Blue Clay	160	170
Sand	170	175
Blue Clay	175	180
Sand	180	185
Blue Clay	185	212
Sand	212	214
Blue Clay	214	220
Sand	220	235
Blue Clay	235	240


**CODED**



DRILLERS REMARKS:

If well telescopes please sketch and show depths.

GROUND LEVEL

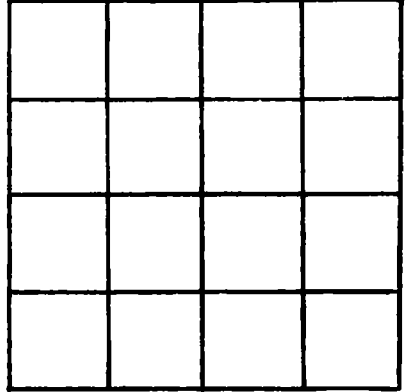

SECTION \_\_\_\_\_

Please indicate well location X.

ADDITIONAL INFORMATION

If more than one screen, show locations of each on sketch.