

HARRISON
L 326
4-6-71

MISSISSIPPI
 BOARD OF WATER COMMISSIONERS
 416 North State Street
 Jackson, Mississippi 39201
WATER WELL DRILLERS LOG

CODED

4-6-71 19
 date well completed

R. T. Moore
 firm name

HARRISON
 county well located

LANDOWNER: M.C. ENYARD

ROBINSON RD

GULFPORT, MISS
 (mailing address)

WELL LOCATION:

sec. 6 T. 2 N R. 11 E
2 miles W of NIURENT
 (distance) (direction) (nearest town)

WELL PURPOSE:
 (home irrigation, municipal, industrial)

WELL COMPLETION DATA:

- (1) diameter (inches) 2"
- (2) total depth (feet) 494'
- (3) static water level (feet) 416' ^{below} _{above} top of ground.
- (4) casing PVC 494'
 (material) (depth)
- _____ if telescope see back.
 (size)
- (5) screen 2x20 494'
 (length) (depth to top)
- 2" SS
 (size) (material)
- (6) pump _____
 (HP) (yield gpm)
- E
 (type power)
- (7) electric log _____
 (yes or no)
- _____ (organization running log)
- (8) how well bottom plugged BW
white

description of formations encountered

from

to

TOP SOIL	0	10
Red Sand	10	41
White Clay	41	60
Blue Clay	60	146
Rusty Sand	146	198
Blue Clay	198	460
GRAV SAND	460	494

CODED


DRILLERS REMARKS:

MAY 3 - 1971

MISS. Bd. OF
 WATER COMM.

If well telescopes please sketch and show depths.

GROUND LEVEL

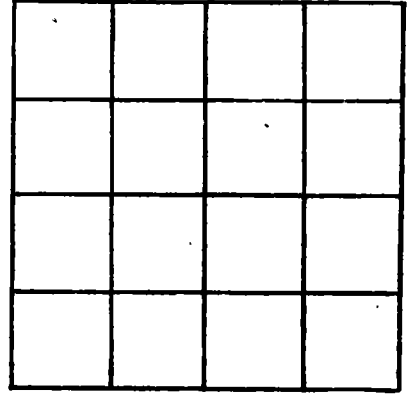

SECTION _____

Please indicate well location X.

ADDITIONAL INFORMATION

If more than one screen,
show locations of each on sketch.