



If well telescopes please sketch and show depths.


GROUND LEVEL

126' 6" of 10" casing

601' of 6" casing

60' of 6" screen

6' of 6" blank pipe

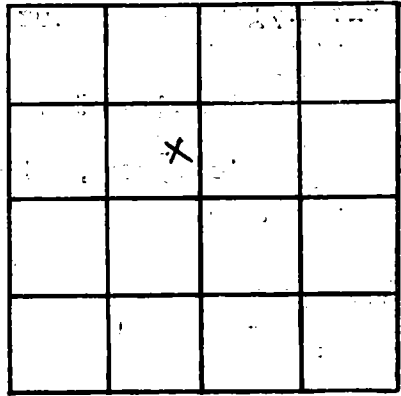

SECTION 15

Please indicate well location X.

ADDITIONAL INFORMATION

If more than one screen, show locations of each on sketch.