

HARRISON
L 334
7-2-71

MISSISSIPPI
BOARD OF WATER COMMISSIONERS
416 North State Street
Jackson, Mississippi 39201

CODED

WATER WELL DRILLERS LOG

7-2-71
date well completed

R. J. Moore
firm name

HARRISON
county well located

LANDOWNER: MIKE WILKINS
RT 1 Box 207
Gulfport MISS
(mailing address)

WELL LOCATION:
sec. 8 T. 7 N. R. 11 E
1 1/2 miles W of LANDOX
(distance) (direction) (nearest town)

description of formations encountered	from	to
TOP SOIL	0	10
Whitesand	10	60
Whitesand	60	80
Blue Clay	100	177
FINE Whitesand	177	209
Blue Clay	209	262
Blue Sand	262	283
Blue Clay	283	293
Blue Sand	293	314
Blue Clay	314	490
Grey Sand	490	536

WELL PURPOSE:
(home, irrigation, municipal, industrial)

WELL COMPLETION DATA:

(1) diameter (inches) 2"

(2) total depth (feet) 536'

(3) static water level (feet) 18' ^{below} above top of ground.

(4) casing PVC 496'
(material) (depth)

(size) If telescope see back.

(5) screen 2x40" 496
(length) (depth to top)

2" SS
(size) (material)

(6) pump 1 1/2 16
(HP) (yield gpm)

E
(type power)

(7) electric log _____
(yes or no)

(organization running log)

(8) how well bottom plugged Yes
with

CODED


JUL 13 1971

MISS. BD. OF
WATER COMM.

DRILLERS REMARKS:

If well telescopes please sketch and show depths.

GROUND LEVEL

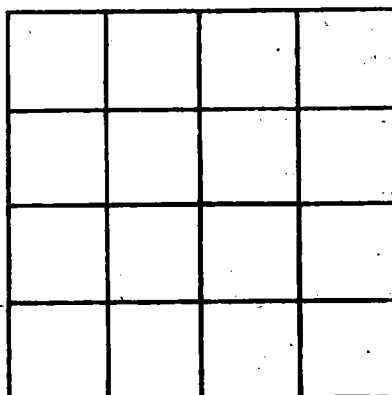

SECTION _____

Please indicate well location X.

ADDITIONAL INFORMATION

If more than one screen, show locations of each on sketch.