

HARRISON
L 335
5-20-71

MISSISSIPPI
 BOARD OF WATER COMMISSIONERS
 416 North State Street
 Jackson, Mississippi 39201

WATER WELL DRILLERS LOG

CODED

May 20 1971 Ladner's Well Users Harrison
 date well completed firm name county well located

LANDOWNER	description of formations encountered	from	to
<u>Russell Allen</u> <u>Landon Rd.</u> <u>Gulfport Miss.</u> (mailing address)			

WELL LOCATION:
 sec. 18 T. 7 N. R. 11 E.
 (S) (W)
6 miles NW of Gulfport
 (distance) (direction) (nearest town)

WELL PURPOSE: home
 (home, irrigation, municipal, industrial)

WELL COMPLETION DATA:

(1) diameter (inches) 2 inch

(2) total depth (feet) 280 ft.

(3) static water level (feet) 30 below above
 top of ground.

(4) casing Galv. 270 ft.
 (material) (depth)
2 inch (size) if telescope see back.

(5) screen 10 ft. 270 ft.
 (length) (depth to top)
2 in. SS.
 (size) (material)

(6) pump 1 6 gal.
 (HP) (yield gpm)
Elec.
 (type power)

(7) electric log NO.
 (yes or no)

(organization running log)

CODED

JUL 21 1971


MISS. Bd. OF
 WATER COMMISSIONERS

(8) how well bottom plugged Ball check

DRILLERS REMARKS:

If well telescopes please sketch and show depths.

GROUND LEVEL

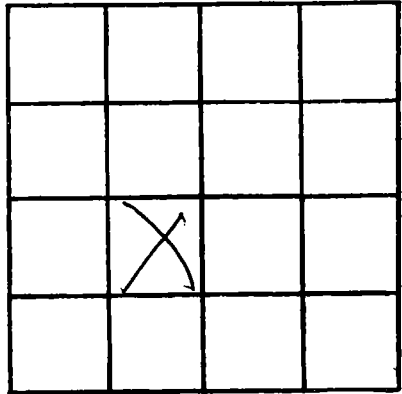

SECTION 18

Please indicate well location X.

ADDITIONAL INFORMATION

If more than one screen, show locations of each on sketch.