

HARRISON
L-336
11-4-70

MISSISSIPPI
BOARD OF WATER COMMISSIONERS
416 North State Street
Jackson, Mississippi 39201

CODED

WATER WELL DRILLERS LOG

11-4-70 19 R. J. Moore HARRISON
date well completed firm name county well located

LANDOWNER: Show's
CONSTRUCTION CO.
Gen Del Gulfport, Miss
(mailing address)

WELL LOCATION:
sec. 2 T. 7 N. R. 1 E.
INDUSTRIAL SOIL
5 miles N of GULFPORT
(distance) (direction) (nearest town)

WELL PURPOSE:
(home, irrigation, municipal, industrial)

WELL COMPLETION DATA:

- (1) diameter (inches) 2"
- (2) total depth (feet) 348'
- (3) static water level (feet) 6' below above top of ground.
- (4) casing SACV 338'
(material) (depth)
(size) if telescope see back.
- (5) screen 2x10 338'
(length) (depth to top)
2" 95
(size) (material)
- (6) pump 1 10
(HP) (yield gpm)
E
(type power)
- (7) electric log yes or no
(organization running log)
- (8) how well bottom plugged Bw
WATER

description of formations encountered	from	to
TOP SOIL	0	10
TOP STRD	10	30
White clay	30	60
Blue clay	60	240
Fine blue sand	240	260
Blue clay	260	300
Blue sand	300	348

This well
FOR WASHING MACH
EQUIPMENT
Well will be pulled
when job completed

~~NOV 10 1970~~

CODED


NOV 10 1970

DRILLERS REMARKS:

MISS. BD. OF
WATER COMM

If well telescopes please sketch and show depths.

GROUND LEVEL

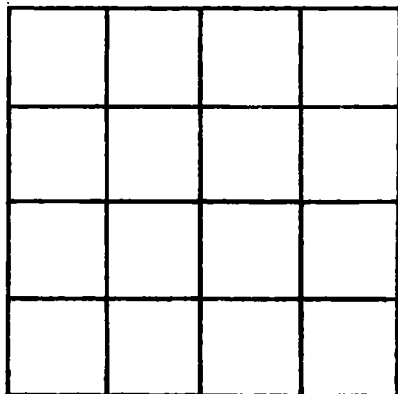

SECTION _____

Please indicate well location X.

ADDITIONAL INFORMATION

If more than one screen,
show locations of each on sketch.