

HARRISON
L 338
12-14-71

MISSISSIPPI
 BOARD OF WATER COMMISSIONERS
 416 North State Street
 Jackson, Mississippi 39201

WATER WELL DRILLERS LOG

CODED

December 14 1971 Ladwier's Well Works HARRISON
 date well completed firm name county well located

LANDOWNER: <u>MARILYN LADWIER</u> <u>Rt. 1, Box 102-A</u>	description of formations encountered	from	to
<u>Pluckett Rd. Nuegent, Miss.</u> (mailing address)	<u>Red Clay</u>	<u>0</u>	<u>80</u>
	<u>Red Sand</u>	<u>80</u>	<u>120</u>
	<u>Blue Clay</u>	<u>120</u>	<u>340</u>
	<u>Blue Sand</u>	<u>340</u>	<u>400</u>

LANDOWNER: MARILYN LADWIER

description of formations encountered

from

to

Rt. 1, Box 102-A

Red Clay

0

80

Red Sand

80

120

Blue Clay

120

340

Blue Sand

340

400

Pluckett Rd. Nuegent, Miss.
(mailing address)

WELL LOCATION:

sec. 2 T. 7 N. R. 11 E.
S. W.

3 miles North of Gulfport
(distance) (direction) (nearest town)

WELL PURPOSE: HOME
(home, irrigation, municipal, industrial)

WELL COMPLETION DATA:

(1) diameter (inches) 2 in.

(2) total depth (feet) 400 FT

(3) static water level (feet) 30 below above top of ground.

(4) casing Galv. 390 ft.
(material) (depth)

2 in. if telescope see back.
(size)

(5) screen 10 ft. 390 ft.
(length) (depth to top)

2 in. S.S.
(size) (material)

(6) pump 1/2 6
(HP) (yield gpm)

Elect.
(type power)

(7) electric log No.
(yes or no)

(organization running log)

(8) how well bottom plugged Ball Check

DRILLERS REMARKS:

CODED


JUL 11 1972

30 ft
300 ft

If well telescopes please sketch and show depths.

02100

GROUND LEVEL

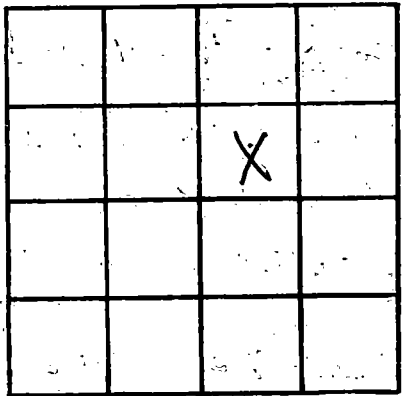

SECTION 02

Please indicate well location X.

ADDITIONAL INFORMATION

02100

If more than one screen, show locations of each on sketch.