

HARRISON

L 345

10-9-72

MISSISSIPPI BOARD OF WATER COMMISSIONERS 416 North State Street Jackson, Mississippi 39201

WATER WELL DRILLERS LOG

Oct 9

date well completed

COOPER H&B Drilling Co. firm name

Harrison

county well located

LANDOWNER:

Temple Lumber Co -

R.R. Cullport, Miss. (mailing address)

WELL LOCATION:

sec. 7 T. 7 S. R. 11 E. 2 miles W of London (distance) (direction) (nearest town)

WELL PURPOSE: Saw mill (home, irrigation, municipal, industrial)

WELL COMPLETION DATA:

- (1) diameter (inches) 2 1/2
(2) total depth (feet) 530
(3) static water level (feet) 30 below top of ground
(4) casing (material) Galv. Steel (depth) 520 (size) 2 1/2" if telescope see back.
(5) screen (length) 10ft (depth to top) 520 (size) 2" (material) Stainless Steel 4/B.
(6) pump (HP) 10 (yield gpm) 2200 lb (type power)
(7) electric log No (yes or no)

(organization running log)

(8) how well bottom plugged 2" Back Wash Valve

description of formations encountered

from to

Table with 3 columns: description of formations encountered, from, to. Rows include Surface Clay, Sand - Brown, White Clay, Blue Clay, Dark Grey Clay, Light Blue Clay, Sand & Clay Breeds, Blue Clay, Brown Sand, Blue Clay, Grey Sand.

Still Cutting Sand when Reithing Completed

COOPER


OCT 24 1972

DRILLERS REMARKS:

MISS. Bd. Of WATER COMM

If well telescopes please sketch and show depths.

GROUND LEVEL

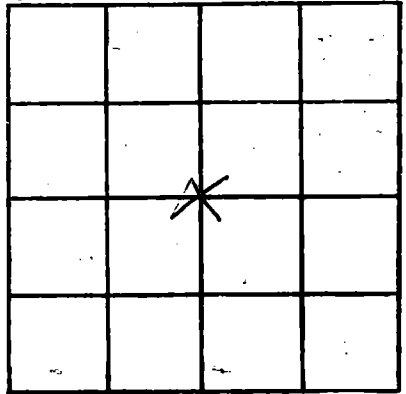

SECTION 2

Please indicate well location X.

ADDITIONAL INFORMATION

If more than one screen, show locations of each on sketch.