

HARRISON

L 349

12-22-72

MISSISSIPPI  
BOARD OF WATER COMMISSIONERS  
416 North State Street  
Jackson, Mississippi 39201  
WATER WELL DRILLERS LOG

**CODED**

12-22-72

date well completed

19

R. J. Moore

firm name

Harrison

county well located

LANDOWNER: H. Payne

description of formations encountered

from

to

RT 1 Box 201

TOP SOIL

0

16

GOLSPORT, MISS

White Sand

16

40

(mailing address)

Blue Clay

40

80

WELL LOCATION:

FINE SAND

80

100

sec. 8 T. 2 N. R. 11 E.

Blue Clay

80

120

1 1/2 miles W of LAMON  
(distance) (direction) (nearest town)

Coarse Blue Sand

120

150

Blue Clay

130

190

Coarse Blue Sand

190

205

WELL PURPOSE:

Blue Clay

25

490

(home, irrigation, municipal, industrial)

Coarse Blue SAND

490

530

WELL COMPLETION DATA:

(1) diameter (inches) 2"

(2) total depth (feet) 530'

(3) static water level (feet) 18' below above top of ground.

(4) casing (material) PVC (depth) 510'

(size) if telescope see back.

(5) screen (length) 20' (depth to top) 510'

(size) 2" (material) SS

(6) pump (HP) 1 (yield gpm) 11

(type power) E

(7) electric log (yes or no)

(organization running log)

(8) how well bottom plugged low


**CODED**

JAN 3 1972

DRILLERS REMARKS:

If well telescopes please sketch and show depths.

GROUND LEVEL

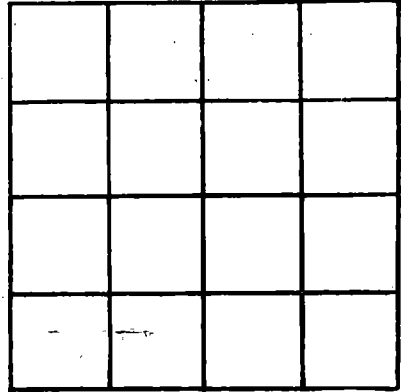

SECTION \_\_\_\_\_

Please indicate well location X.

ADDITIONAL INFORMATION

A series of horizontal lines for recording additional information, starting below the 'ADDITIONAL INFORMATION' header and extending to the bottom of the page.

If more than one screen, show locations of each on sketch.