

HARRISON

L 351

1-27-73

MISSISSIPPI BOARD OF WATER COMMISSIONERS
416 North State Street
Jackson, Mississippi 39201

CODED

WATER WELL DRILLERS LOG

1-27-1973
date well completed

R. J. Moore
firm name

HARRISON
county well located

LANDOWNER: C. S. Aricle

description of formations encountered

from to

Three Rivers RD - Box 190

TOP SOIL

0 10

RT #3 GULFBLVD, MISS
(mailing address)

White Sand

10 30

Blue + white clay

30 100

SILTY Blue Sand

100 146

Blue Clay

146 225

Blue Sand

225 242

WELL LOCATION:

sec. 2 T. 2 N. R. 11 E. W. 4

1 miles E of NUGENT
(distance) (direction) (nearest town)

WELL PURPOSE:

(Home, Irrigation, municipal, industrial)

WELL COMPLETION DATA:

- (1) diameter (inches) 2"
- (2) total depth (feet) 242'
- (3) static water level (feet) 38' below top of ground

- (4) casing 2 1/2" (material), 222 (depth)

(size) If telescope see back.

- (5) screen 10' (length), 232' (depth to top)

2" (size), 95 (material)

- (6) pump 1 (HP), 10 (yield gpm)

E (type power)

- (7) electric log (yes or no)

(organization running log)

- (8) how well bottom plugged


See above

DRILLERS REMARKS:

FEB 1973

If well telescopes please sketch and show depths.

GROUND LEVEL

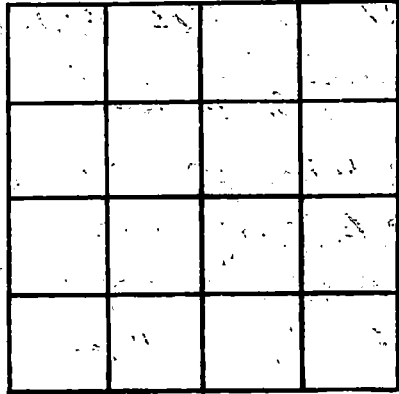

SECTION _____

Please Indicate well location X.

ADDITIONAL INFORMATION

If more than one screen, show locations of each on sketch.