

HARRISON
L 354
2-15-73

MISSISSIPPI
 BOARD OF WATER COMMISSIONERS
 416 North State Street
 Jackson, Mississippi 39201

CODED

WATER WELL DRILLERS LOG

2-15 1973 Switzer Well Company Harrison
 date well completed firm name county well located

LANDOWNER: Nancy Schmitt
Qt. 1 Box 126 H
Sauces, Miss. 39574
 (mailing address)

WELL LOCATION:
 sec. 6 T 7 R 11 E
 S W
6 miles N of Gulfport
 (distance) (direction) (nearest town)

WELL PURPOSE: Home
 (home, irrigation, municipal, industrial)

- WELL COMPLETION DATA:
- (1) diameter (inches) 2"
 - (2) total depth (feet) 240'
 - (3) static water level (feet) 47' below above
 top of ground.
 - (4) casing galv., 240'
 (material) (depth)
 (size) if telescope see back.
 - (5) screen 10', 230'
 (length) (depth to top)
008, stainless steel
 (size) (material)
 - (6) pump 1 6
 (HP) (yield gpm)
electric
 (type power)
 - (7) electric log no
 (yes or no)
 (organization running log)
 - (8) how well bottom plugged leak
pressure valve

description of formations encountered	from	to
<u>Clay</u>	<u>0</u>	<u>88</u>
<u>Sand</u>	<u>88</u>	<u>100</u>
<u>Sand, good red</u>	<u>100</u>	<u>105</u>
<u>Clay</u>	<u>105</u>	<u>197</u>
<u>Sand</u>	<u>197</u>	<u>200</u>
<u>Sand, good</u>	<u>200</u>	<u>240</u>


CODED

DRILLERS REMARKS:

MAD 1 B 1973

If well telescopes please sketch and show depths.

GROUND LEVEL

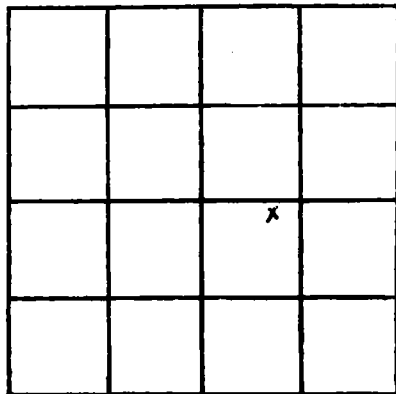

SECTION 6

Please indicate well location X.

ADDITIONAL INFORMATION

If more than one screen,
show locations of each on sketch.