

MISSISSIPPI  
BOARD OF WATER COMMISSIONERS  
416 North State Street  
Jackson, Mississippi 39201

**CODED**

**WATER WELL DRILLERS LOG**

~~Shallow well~~  
**HARRISON**  
**L. 359**  
**1-28-72**

Jan. 28 1972 Mc Hill Well Works Harrison  
date well completed firm name county well located

LANDOWNER: Cornel Peak

description of formations encountered

from

to

Gulfport, Miss

top soil  
sand

0 2  
28

(mailing address)

**WELL LOCATION:**

sec. 24 T 2 N R 10 E  
2 miles E of Gulfport  
(distance) (direction) (nearest town)

**WELL PURPOSE:** Drinking  
(home, irrigation, municipal, industrial)

**WELL COMPLETION DATA:**

- (1) diameter (inches) 2"
- (2) total depth (feet) 28'
- (3) static water level (feet) 2' below above top of ground.
- (4) casing plastic 18'  
(material) (depth)  
2"  
(size) If telescope see back.
- (5) screen 10'  
(length) (depth to top)  
2" plastic  
(size) (material)
- (6) pump 1/2 12  
(HP) (yield gpm)  
Electric  
(type power)
- (7) electric log no  
(yes or no)

(organization running log)


(8) how well bottom plugged sand  
Shark

**DRILLERS REMARKS:**

**CODED**

If well telescopes please  
sketch and show depths.

GROUND LEVEL

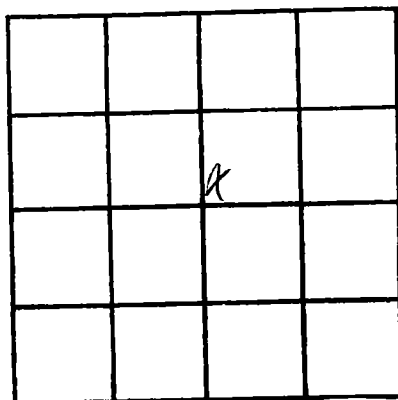

SECTION 24

Please indicate well location X.

ADDITIONAL INFORMATION

If more than one screen,  
show locations of each on sketch.