

**MISSISSIPPI
BOARD OF WATER COMMISSIONERS**
416 North State Street
Jackson, Mississippi

CODED

WATER WELL DRILLERS LOG

HARRISON
L360
4-17-73

4-17-73 19 R J. Moore HARRISON
date well completed firm name county well located

LANDOWNER: J. A. BRYAN
RT #1 Box 201
GULFPORT, MISS
(mailing address)

WELL LOCATION:
sec. 8 T. 2 N. R. 1 E
1 miles WEST of LADON
(distance) (direction) (nearest town)

description of formations encountered	from	to
<u>TOP SOIL</u>	<u>0</u>	<u>10</u>
<u>Coarse white sand</u>	<u>10</u>	<u>30</u>
<u>blue clay</u>	<u>30</u>	<u>160</u>
<u>SILTY sand</u>	<u>160</u>	<u>175</u>
<u>blue clay</u>	<u>175</u>	<u>190</u>
<u>FINE blue sand</u>	<u>190</u>	<u>226</u>
<u>Blue CLAY</u>	<u>220</u>	<u>320</u>
<u>Coarse Grady sand</u>	<u>320</u>	<u>394</u>

WELL PURPOSE:
(home, irrigation, municipal, industrial)

WELL COMPLETION DATA:

(1) diameter (inches) 2"

(2) total depth (feet) 394'

(3) static water level (feet) 15' ^{below} above ground.

(4) casing 944 384'
(material) (depth)
(size) if telescope see back.

(5) screen 10' 384'
(length) (depth to top)
2" SS
(size) (material)

(6) pump 1 12
(HP) (yield gpm)
E
(type power)

(7) electric log _____
(yes or no)

(organization running log)


(8) how well bottom plugged BSW
blue

CODED

DRILLERS REMARKS:

If well telescopes please sketch and show depths.

GROUND LEVEL

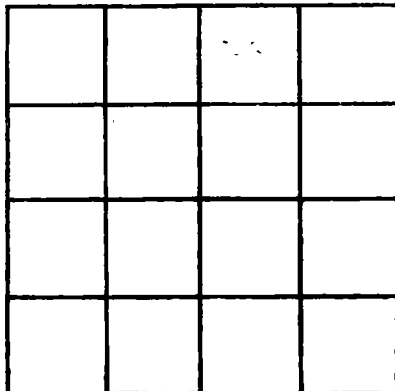

SECTION _____

Please indicate well location X.

ADDITIONAL INFORMATION

If more than one screen, show locations of each on sketch.