

HARRISON  
L 369  
1-10-73

MISSISSIPPI  
 BOARD OF WATER COMMISSIONERS  
 416 North State Street  
 Jackson, Mississippi 39201

**CODED**

WATER WELL DRILLERS LOG

Jan 10 1973 N.A. Ladner's Well Works HARRISON  
 date well completed firm name county well located

LANDOWNER: MR. ALLEN SMITH  
BILOXI RIVER ESTATES

description of formations encountered	from	to
<u>Red Clay &amp; SAND</u>	<u>0</u>	<u>60</u>
<u>White SAND</u>	<u>60</u>	<u>80</u>
<u>Blue Clay</u>	<u>80</u>	<u>180</u>
<u>Fine Blue SAND</u>	<u>180</u>	<u>220</u>
<u>Blue Clay</u>	<u>220</u>	<u>498</u>
<u>Blue SAND</u>	<u>448</u>	<u>508</u>

(mailing address)

WELL LOCATION:

sec. 2 T. 7 R. 11  
 S W  
2 miles east of LYMAN  
 (distance) (direction) (nearest town)

WELL PURPOSE: HOME  
 (home, irrigation, municipal, industrial)

WELL COMPLETION DATA:

- (1) diameter (inches) 2 inch
- (2) total depth (feet) 508 FT.
- (3) static water level (feet) 30 below top of ground.
- (4) casing Galv., 498 FT.  
 (material) (depth)
- 2 in. If telescope see back.  
 (size)
- (5) screen 10 FT., 498 FT.  
 (length) (depth to top)
- 2 in., S. STEEL  
 (size) (material)
- (6) pump 1, 8  
 (HP) (yield gpm)
- Elect.  
 (type power)
- (7) electric log NO  
 (yes or no)

(organization running log)

(8) how well bottom plugged Ball Check


DRILLERS REMARKS:

**CODED**

JUN 22 1973

If well telescopes please sketch and show depths.

GROUND LEVEL

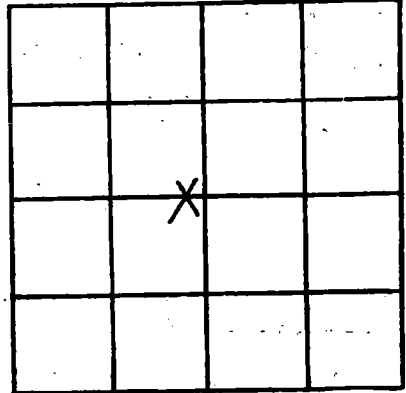

SECTION 2

Please indicate well location X.

ADDITIONAL INFORMATION

If more than one screen, show locations of each on sketch.