

896-4980
 HARRISON
 L370
 7-23-73

MISSISSIPPI
 BOARD OF WATER COMMISSIONERS
 416 North State Street
 Jackson, Mississippi 39201

WATER WELL DRILLERS LOG

CO.

June 4 19 73 McGil well works Harrison
 date well completed firm name county well located

LANDOWNER: Robert Mitchell

House 30 Bayou View Drive
 Biloxi, Miss.
 (mailing address)

description of formations encountered

from to

Clay	0	12
sand	12	30

WELL LOCATION:

Sec 23 N 23 R 11 E
 S W
 miles direction (nearest town)

WELL PURPOSE: Irrigation
 (home, irrigation, municipal, industrial)

WELL COMPLETION DATA:

- (1) diameter (inches) 2"
- (2) total depth (feet) 30'
- (3) static water level (feet) 3' below top of ground
- (4) casing plastic 20" (material) (depth)
- (size) if telescope see back.
- (5) screen 10' (length) (depth to top)
- (size) (material) plastic
- (6) pump 1/2 (HP) 10 (yield gpm)
- Electric (type power)
- (7) electric log no (yes or no)

(organization running log)


(8) how well bottom plugged plug

DRILLERS REMARKS:

JUL 19 1973

If well telescopes please sketch and show depths.

GROUND LEVEL

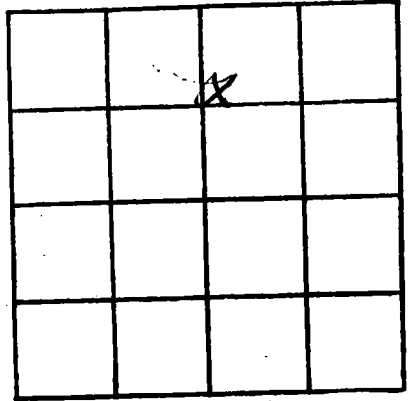

On Blue
SECTION _____

Please indicate well location X.

ADDITIONAL INFORMATION

Lined area for additional information.

If more than one screen, show locations of each on sketch.