

Harrison
L373
8-2-73

MISSISSIPPI
BOARD OF WATER COMMISSIONERS
416 North State Street
Jackson, Mississippi 39201
WATER WELL DRILLERS LOG

CODED

Aug. 2 1973 McEgill well works Harrison
date well completed firm name county well located

LANDOWNER Mrs. Bourdin
25 Bayou View Drive
Biloxi, Mo.
(mailing address)

description of formations encountered	from	to
clay	0	18
course sand	18	30

WELL LOCATION:

sec 24 T 2 N R 11 E
2 miles N of Miss City
(distance) (direction) (nearest town)

WELL PURPOSE: irrigation
(home, irrigation, municipal, industrial)

WELL COMPLETION DATA:

- (1) diameter (inches) 2"
- (2) total depth (feet) 30'
- (3) static water level (feet) 2' below top of ground
- (4) casing plastic 20'
(material) (depth)
If telescope see back.
(size)
- (5) screen 10'
(length) (depth to top)
2" (size) plastic (material)
- (6) pump 1/2 12
(HP) (yield gpm)
Electric (type power)
- (7) electric log no
(yes or no)
(organization running log)
- (8) how well bottom plugged plug

CODED


SEP 10 1973

DRILLERS REMARKS:

MISS. DIV. OF
WATER COMM.

If well telescopes please sketch and show depths.

GROUND LEVEL

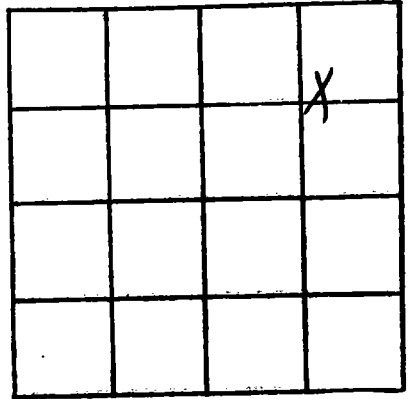

SECTION 24

Please indicate well location X.

ADDITIONAL INFORMATION

If more than one screen,
show locations of each on sketch.