

MISSISSIPPI
 BOARD OF WATER COMMISSIONERS
 416 North State Street
 Jackson, Mississippi 39201
 WATER WELL DRILLERS LOG

CODED

Harrison
 L375
 8-26-73

8-20-73 19 R. J. Moore HARRISON
 date well completed firm name county well located


LANDOWNER: <u>KENNETH BOVEQUE</u> <u>RT 4 BOX 450</u>	description of formations encountered	from	to
<u>GOLSPRINT, MISS</u> (mailing address)	<u>TOP SOIL</u>	<u>0</u>	<u>10</u>
WELL LOCATION: sec. <u>9</u> T. <u>7</u> N. R. <u>11</u> E. <u>1/2</u> miles <u>E</u> of <u>Orange Grove</u> (distance) (direction) (nearest town)	<u>White Clay</u>	<u>10</u>	<u>20</u>
WELL PURPOSE: (home, irrigation, municipal, industrial)	<u>White Sand</u>	<u>20</u>	<u>450</u>
WELL COMPLETION DATA: (1) diameter (inches) <u>2"</u>	<u>Blue Clay</u>	<u>450</u>	<u>460</u>
(2) total depth (feet) <u>500'</u>	<u>Gravel Sand</u>	<u>460</u>	<u>500</u>
(3) static water level (feet) <u>4'</u> <u>below</u> above top of ground.			
(4) casing <u>7/8"</u> <u>490'</u> (material) (depth)			
(5) screen <u>10'</u> <u>490'</u> (length) (depth to top)			
<u>2"</u> <u>SS</u> (size) (material)			
(6) pump <u>1</u> <u>10</u> (HP) (yield gpm)			
<u>E</u> (type power)			
(7) electric log _____ (yes or no)			
(8) how well bottom plugged _____ <u>Partially</u>			
DRILLERS REMARKS:			

CODED

SEP 7 1973

If well telescopes please sketch and show depths.

GROUND LEVEL

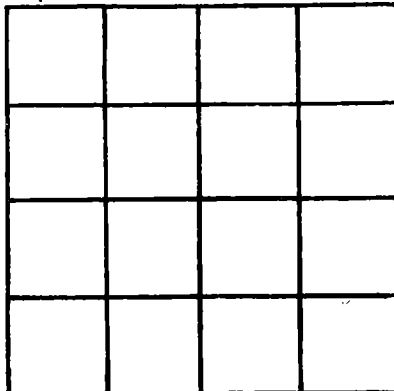

SECTION _____

Please indicate well location X.

ADDITIONAL INFORMATION

If more than one screen, show locations of each on sketch.